


**LAND CORNER RECORDATION CERTIFICATE**  
**Filing Requirement of Act 74, Mich. P.A. 1970**

For corners in  
Iron

Located In:	Corner Code #
T <u>43N</u> R <u>33W</u>	<u>E3</u>
T _____ R _____	_____
T _____ R _____	_____
T _____ R _____	_____
T _____ R _____	_____
S _____ T _____ R _____	_____
S _____ T _____ R _____	_____
S _____ T _____ R _____	_____
S _____ T _____ R _____	_____

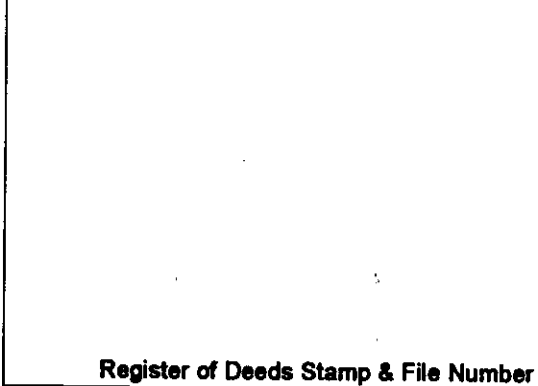

1. Public Land Survey

2. Property Controlling in Section

3. Miscellaneous Property in Sec.

4. Lot No. \_\_\_\_\_, Recorded Plat \_\_\_\_\_  
 5. Private Claims \_\_\_\_\_

Mar 25 2003

I, Stephan J. Szyszkoski, in a field survey on \_\_\_\_\_, 20\_\_ do hereby state that under requirements of P.A. 74, Michigan P.A. of 1970, the corner points mentioned in lines 1 and 2 above were in conformance with regulations and rules therefore as required in the current manual of survey instructions of the United States Department of the Interior, Bureau of Land Management or by a decree of a Court of Law and/or that the corner points mentioned in lines 3, 4 and 5 above were in conformance with the rules of the Michigan Board of Land Surveyors or by a Decree of a Court of Law; established, re-established, monumented, recovered, found as expressed below:

NOTE: Not more than 2 corners, all in the same town and range, may be recorded on this certificate.

A	B	C	D	E	F	G	H	I	J	K	L	M
1												
2	6		5		4		3		2		1	
3				●								
4	7		8		9		10		11		12	
5												
6	18		17		16		15		14		13	
7												
8	19		20		21		22		23		24	
9												
10	30		29		28		27		26		25	
11												
12	31		32		33		34		35		36	
13												

A. Description of original monument and accessories and/or subsequent restoration:  
 (E3) Corner common to Sections 4-5-8-9. 1974: Record of A.O. Enger RLS states: "Re-established 6/26/74 proportionately E&M between original corners 2 miles W and 1/2 mile E, and proportionately N&S between an original corner 1 mile N and the presumed 1/4 cor. location in Chicaugon Creek 1/2 mile S. Set 1"IDx36" iron pipe with 3.5" aluminum cap. White Pine 16 N46E 71.1', Sugar Maple 6 S79W 48.6'."

B. Description of corner evidence found and/or method applied in restoring or reestablishing corner:  
 (E3) The 1974 monument was recovered in good condition and at record bearing and distance from the W.Pine NBT. The Sugar NBT is gone. My measurements to corners C3 and D3 west, and MCs 7a and 14a and cor. E5 south suggest that the monument is not located in the position intended by Mr. Enger. I examined Mr. Enger's field notes, his computations by which he determined the proportionate position noted above, and his final report of survey. I concluded that the computations and field measurements are correct but that the monument was erroneously installed 9.67' south of the desired proportionate position. I removed Mr. Enger's monument and reestablished the corner at the position intended in 1974, being the proportionate position, 9.67' north of the position monumented by Mr. Enger. Removed the 1974 monument.

C. Description of monument for corner and accessories established to perpetuate locating the position of the corner:  
 (E3) Set 1"IDx32" Iron pipe with 4" dia. alum. MDNR cap. Blazed, scribed, and set measuring nails in:  
 7" Maple N01W 16.0' "S5 NBT"  
 9" Maple N34E 37.2' "S4 NBT"  
 17" W.Pine N57E 65.3' "S4 NBT"  
 7" Maple S26E 10.55' "S9 NBT"  
 The W.Pine NBT is the W.Pine originally marked in 1974. Set squared post adjacent. Bearings are magnetic. Dist. are to nail with plastic tag.  
 Signed by Stephan J. Szyszkoski Date 4/3/2003  
 Surveyor's Michigan License No. 33986

