

LAND CORNER RECORDATION CERTIFICATE
Filing Requirement of Act 74, Mich. P.A. 1970 as Amended

For corners in

<u>Iron</u> <small>(County)</small>	Located In:	Corner Code #	
1. Public Land Survey	T ___ R ___ T ___ R ___ T ___ R ___	_____	_____
2. Property Controlling in Section	S <u>18</u> T <u>43N</u> R <u>33W</u> S ___ T ___ R ___	_____	_____
3. Miscellaneous Property in Sec.	S ___ T ___ R ___ S ___ T ___ R ___	_____	_____
4. Lot No. _____, Recorded Plat _____			
5. Private Claims			

Register of Deeds Stamp & File Number

	A	B	C	D	E	F	G	H	I	J	K	L	M
1													
2	6		5		4		3		2		1		
3													
4	7		8		9		10		11		12		
5													
6	18		17		16		15		14		13		
7	●●												
8	19		20		21		22		23		24		
9													
10	30		29		28		27		26		25		
11													
12	31		32		33		34		35		36		
13													

I, Stephan J. Szyszkoski, in a field survey on Jan 23, 2008 do hereby state that under requirements of P.A. 74, Michigan P.A. of 1970, the corner points mentioned in lines 1 and 2 above were in conformance with regulations and rules therefore as required in the current manual of survey instructions of the United States Department of the Interior, Bureau of Land Management or by a decree of a Court of Law and /or that the corner points mentioned in lines 3, 4 and 5 above were in conformance with the rules of the Michigan Board of Land Surveyors or by a Decree of a Court of Law; established, re-established, monumented, recovered, found as expressed below:

NOTE: Not more than 2 corners, all in the same town and range, may be recorded on this certificate.

A. Description of original monument and accessories and/or subsequent restoration:

(13-Sec. 18) Southeast 1/16 corner, Sec. 18. Not established in the original survey.

(12-Sec. 18) South 1/16 corner, Sec. 18. Not established in the original survey.

B. Description of corner evidence found and/or method applied in restoring or reestablishing corner:

(13-Sec. 18) Established the corner at the intersection of straight lines connecting opposite 1/16 corners. From the corner thus established, an E-W barbed-wire fence is 16' south, a barbed-wire fence running north is 62' east, and a barbed-wire fence running south is approximately 50' east.

(12-Sec. 18) Established the corner midway and on a straight line between Center of Section 1324.94' north and Quarter corner 1324.94' south. From the corner thus established, a fence corner, with fences running north and east, bears S87E 72.5' distant.


C. Description of monument for corner and accessories established to perpetuate locating the position of the corner:

(13) Set 1"IDx32" I.pipe with 4" alum. MDNR cap.
 Set measuring nail with MDNR tag in the side of:
 10" Maple S22E 24.95' mrkd "1/16S BT"
 6" W.Birch S55W 26.1' do
 4" Maple N58W 44.1' do
 4" Maple N10W 18.45' do
 Set sq'd post adjacent. Bearings are magnetic.

(12) Set 1"IDx32" I.pipe with 4" alum. MDNR cap.
 Set measuring nail with MDNR tag in the side of:
 4" Sugar N06E 4.6' mrkd "1/16S BT"
 3" Ash S69E 12.2' do
 7" Poplar S45W 10.0' do
 4" Basswood N48W 29.6' do
 Set sq'd post adjacent. Bearings are magnetic.

Signed by

Stephan J. Szyszkoski

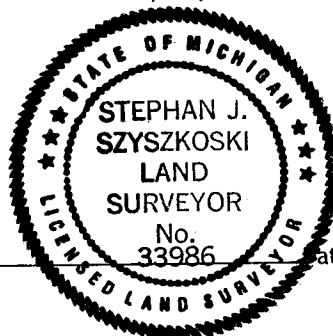

Date 2/5/08

Surveyor's Michigan License No. 33986