

**LAND CORNER RECORDATION CERTIFICATE**  
**Filing Requirement of Act 74, Mich. P.A. 1970 as Amended**

For corners in

<u>Iron</u> <small>(County)</small>	Located In:	Corner Code #	
1. Public Land Survey	T ___ R ___	_____	
	T ___ R ___	_____	
	T ___ R ___	_____	
2. Property Controlling in Section	S <u>19</u> T <u>43N</u> R <u>33W</u>	<u>15</u>	
3. Miscellaneous Property in Sec.	S <u>19</u> T <u>43N</u> R <u>33W</u>	<u>16</u>	
	S ___ T ___ R ___	_____	
	S ___ T ___ R ___	_____	
4. Lot No. _____, Recorded Plat _____			
5. Private Claims			

**Register of Deeds Stamp & File Number**

I, Stephan J. Szyszkoski, in a field survey on Jan 31, 2008 do hereby state that under requirements of P.A. 74, Michigan P.A. of 1970, the corner points mentioned in lines 1 and 2 above were in conformance with regulations and rules therefore as required in the current manual of survey instructions of the United States Department of the Interior, Bureau of Land Management or by a decree of a Court of Law and /or that the corner points mentioned in lines 3, 4 and 5 above were in conformance with the rules of the Michigan Board of Land Surveyors or by a Decree of a Court of Law; established, re-established, monumented, recovered, found as expressed below:

**NOTE: Not more than 2 corners, all in the same town and range, may be recorded on this certificate.**

A. Description of original monument and accessories and/or subsequent restoration:

	A	B	C	D	E	F	G	H	I	J	K	L	M
1													
2		6		5		4		3		2		1	
3													
4		7		8		9		10		11		12	
5													
6		18		17		16		15		14		13	
7													
8		19		20		21		22		23		24	
9	●	●											
10		30		29		28		27		26		25	
11													
12		31		32		33		34		35		36	
13													

(15-Sec. 19) West 1/16 corner between Sections 19 and 30. Not established in the original survey. The original Government plat gives dimensions 20.00 chains east to Quarter corner and 19.81 chains west to Section corner.

(16-Sec. 19) East 1/16 corner between Sections 19 and 30. Not established in the original survey.

B. Description of corner evidence found and/or method applied in restoring or reestablishing corner:

(15-Sec. 19) Established the corner on the Section line between Quarter corner 1323.04' east and Section corner 1310.47' west, being the position proportionate to the dimensions given on the face of the original Government plat.


(16-Sec. 19) Established the corner midway and on the Section line between Quarter corner 1323.02' west and Section corner 1323.02' east.

C. Description of monument for corner and accessories established to perpetuate locating the position of the corner:

(15) Set 1"IDx32" I.pipe with 4" alum. MDNR cap.  
 Set measuring nail with MDNR tag in the side of:  
 Basswood N24W 6.55' mrkd "1/16S BT"  
 6" Sugar N73E 17.95' do  
 12" twin Oak S27E 35.3' do  
 4" Sugar S61W 16.8' do  
 Set sq'd post adjacent. Bearings are magnetic.

(16) Set 1"IDx32" I.pipe with 4" alum. MDNR cap.  
 Set measuring nail with MDNR tag in the side of:  
 19" Oak N09E 18.75' mrkd "1/16S BT"  
 9" Sugar N88E 14.1' do  
 9" Sugar S03E 6.75' do  
 6" Sugar N52W 10.35' do  
 Set sq'd post adjacent. Bearings are magnetic.

Signed by Stephan J. Szyszkoski

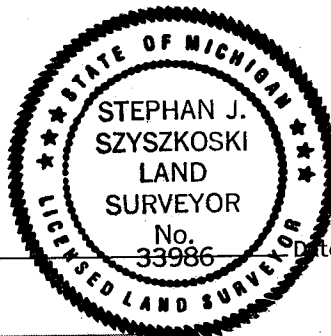

Date 2/5/08

Surveyor's Michigan License No. 33986