

SURVEY & REMONUMENTATION

JAN 19 1999

SECTION

LAND CORNER RECORDATION CERTIFICATE
Filing Requirement of Act 74, Mich. P.A. 1970

For corners in

Iron (County)	Located In:	Corner Code #
1. Public Land Survey	T <u>43N</u> R <u>34W</u>	<u>C-7</u>
	T _____ R _____	_____
	T _____ R _____	_____
	T _____ R _____	_____
2. Property Controlling in Section	S _____ T _____ R _____	_____
	S _____ T _____ R _____	_____
3. Miscellaneous Property in Sec.	S _____ T _____ R _____	_____
	S _____ T _____ R _____	_____

IRON COUNTY MICHIGAN
RECEIVED FOR RECORD


98 DEC 28 AM 11:10
L.C. Record: L. 7, P. 234
Gilbert Stiles
REGISTER OF DEEDS

Register of Deeds Stamp & File Number

4. Lot No. _____, Recorded Plat _____
5. Private Claims _____

Section Corner Sections 18, 17, 19, 20, T43N, R34W

I, Gary L. Pisoni, in a field survey on October 5, 1994 do hereby state that under requirements of P.A. 74, Michigan P.A. of 1970, the corner points mentioned in lines 1 and 2 above were in conformance with regulations and rules therefore as required in the current manual of survey instructions of the United States Department of the Interior, Bureau of Land Management or by a decree of a Court of Law and /or that the corner points mentioned in lines 3, 4 and 5 above were in conformance with the rules of the Michigan Board of Land Surveyors or by a Decree of a Court of Law; established, re-established, monumented, recovered, found as expressed below:

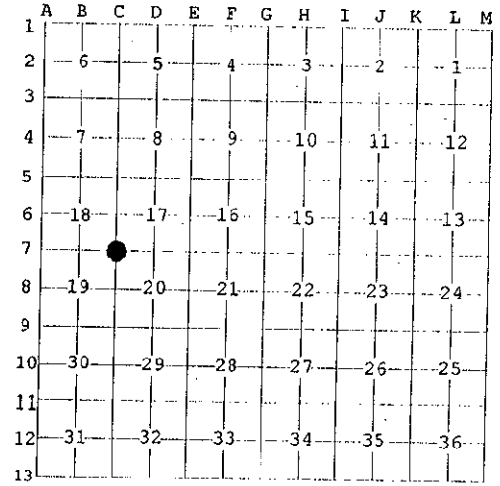

NOTE: Not more than 2 corners, all in the same town and range, may be recorded on this certificate.

A. Description of original monument and accessories and/or subsequent restoration:

Original corner established in 1851 by Guy H. Carleton, U.S. Deputy Surveyor.

Original Corner; Wood Post
Original Bearing Trees:

Elm	20"	N 24° E	18 lks (11.88 feet)
Yellow Birch	18"	S 52° W	50 lks (33.00 feet)

PEER GROUP APPROVED
Iron A. Pisoni 11-24-98
COUNTY REPRESENTATIVE

B. Description of corner evidence found and/or method applied in restoring or reestablishing corner:

No evidence of original B.T.s found.

Found an iron pipe located 12" below a gravel road bed surface and in line with a fence line running East and North. Corner has been in existence for over 30 years and has been used for many surveys in the area. I accept the iron pipe as the best available evidence for restoring the corner position.

Distances to adjoining corners are consistent with GLO distances.

Corner record research on file with the County Representative.

C. Description of monument for corner and accessories established to perpetuate locating the position of the corner:


Over the top of the existing iron pipe, set a 2" diameter by 30" long split base aluminum pipe monument, 6" below road bed surface, with a 3" aluminum cap, stamped as follows: Iron County Remonumentation, T43N, R34W, S-17, S-18, S-19, S-20, 1994, RLS 27457 from which I established the following new blazed and scribed bearing trees: (All measurements taken to a nail in side of tree)

Sugar Maple	8"	S 76° E	25.93 feet
Sugar Maple	12"	S 13° W	37.00 feet
Sugar Maple	12"	S 41° W	37.12 feet
Sugar Maple	11"	N 41° W	48.08 feet
Steel sign post		S 01° W	17.95 feet
Sugar Maple	10"	S 17° E	34.06 feet

98-17
Signed by Gary L. Pisoni Date 12-21-98

Surveyor's Michigan License No. 27457

FORM APPROVED BY MICHIGAN STATE BOARD OF PROFESSIONAL SURVEYORS, JAN. 28, 1971
REVISED MAY 14, 1975
REVISED JAN., 1983
REVISED OCT., 1995

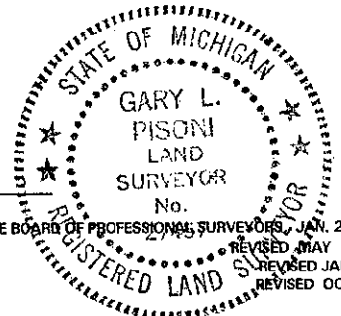

L. 7 P. 234