

SURVEY & REMONUMENTATION

JAN 19 1999

SECTION

**LAND CORNER RECORDATION CERTIFICATE
Filing Requirement of Act 74, Mich. P.A. 1970**

For corners in

<u>Iron</u> (County)	Located in:	Corner Code #	
1. Public Land Survey	T <u>43N</u> R <u>34W</u>	<u>E-3</u>	
	T _____ R _____	_____	
	T _____ R _____	_____	
	T _____ R _____	_____	
2. Property Controlling in Section	S _____ T _____ R _____	_____	
	S _____ T _____ R _____	_____	
3. Miscellaneous Property in Sec.	S _____ T _____ R _____	_____	
	S _____ T _____ R _____	_____	

**IRON COUNTY
MICHIGAN
RECEIVED FOR RECORD**

98 DEC 28 AM 11:10

L.C. Record: L. 7, P. 232

Gilbert Steble

REGISTERED LAND SURVEYORS

Register of Deeds Stamp & File Number

4. Lot No. _____, Recorded Plat _____
5. Private Claims _____

Section Corner Sections 5, 4, 8, 9, T43N, R34W

I, Gary L. Pisoni, in a field survey on October 20, 1998 do hereby state that under requirements of P.A. 74, Michigan P.A. of 1970, the corner points mentioned in lines 1 and 2 above were in conformance with regulations and rules therefore as required in the current manual of survey instructions of the United States Department of the Interior, Bureau of Land Management or by a decree of a Court of Law and/or that the corner points mentioned in lines 3, 4 and 5 above were in conformance with the rules of the Michigan Board of Land Surveyors or by a Decree of a Court of Law; established, re-established, monumented, recovered, found as expressed below:

	A	B	C	D	E	F	G	H	I	J	K	L	M
1													
2	6			5		4		3		2		1	
3					●								
4	7			8		9		10		11		12	
5													
6	18			17		16		15		14		13	
7													
8	19			20		21		22		23		24	
9													
10	30			29		28		27		26		25	
11													
12	31			32		33		34		35		36	
13													

NOTE: Not more than 2 corners, all in the same town and range, may be recorded on this certificate.

A. Description of original monument and accessories and/or subsequent restoration:

Original corner established in 1851 by Guy H. Carleton, U.S. Deputy Surveyor.

Original Corner; Wood Post

Original Bearing Trees:

White Pine	40"	N 50°W	40 lks (26.40 feet)
Fir	9"	S 20°E	16 lks (10.56 feet)

B. Description of corner evidence found and/or method applied in restoring or reestablishing corner:

No evidence of original B.T.s found.

Found a rebar pin located 12" South of the centerline of Demboski Road and in line with an old fence line running South.

Corner has been in existence for over 30+ years and has been used for many surveys in Sections 4, 5, 8 and 9. Distances to adjoining corners are consistent with GLO distances.

I accept the rebar pin as the best available evidence for restoring the corner position.

Corner record reseach on file with County Representative.

PEER GROUP APPROVED
Iron A. Pisoni 11-24-98
COUNTY REPRESENTATIVE


C. Description of monument for corner and accessories established to perpetuate locating the position of the corner:

Set two (2) reference monuments being a 5/8" diameter by 30" long rebar pin with a 3" diameter aluminum cap stamped as follows: Iron County Remonumentation, T43N, R34W, R.M., S-4, S-5, S-8, S-9, N 50° E, 52.45', 1998, RLS 27457; T43N, R34W, R.M., S-4, S-5, S-8, S-9, S 32° E, 36.13', 1998, RLS 27457 from which I established the following new blazed and scribed bearing trees: (All measurements taken to a nail in side of tree)

Ash	5"	South	42.51 feet
R.M. 5/8" x 30" rebar		S 50° W	52.45 feet
R.M. 5/8" x 30" rebar		N 32° W	36.13 feet
Spruce	13"	N 13° E	40.73 feet
Steel sign post		S 01° W	26.25 feet

98-14
Signed by Gary L. Pisoni Date 12-21-98
Surveyor's Michigan License No. 27457

FORM APPROVED BY MICHIGAN STATE BOARD OF PROFESSIONAL SURVEYORS, JAN. 28, 1971
REVISOR: JAMES J. HARRIS, JR., MAY 14, 1975
REVISOR: JAMES J. HARRIS, JR., JAN. 1983
REVISOR: JAMES J. HARRIS, JR., OCT., 1995

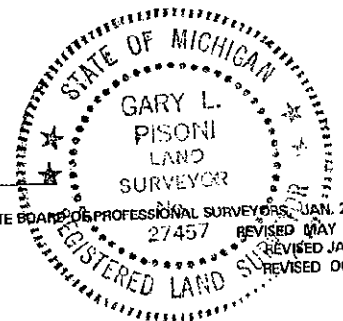

L. 7 P. 232