

SURVEY & REMONUMENTATION

APR 27 1995

COMMISSION

LAND CORNER RECORDATION CERTIFICATE Filing Requirement of Act 74, Mich. P.A. 1970

For corners in

<u>Iron</u>			
(County)	Located In:	Corner Code #	
1. Public Land Survey	T 43N R 34W	E-8	
	T _____ R _____	_____	_____
	T _____ R _____	_____	_____
	T _____ R _____	_____	_____
2. Property Controlling in Section	S _____ T _____ R _____	_____	_____
	S _____ T _____ R _____	_____	_____
3. Miscellaneous Property in Sec.	S _____ T _____ R _____	_____	_____
	S _____ T _____ R _____	_____	_____

REGISTERS OFFICE)
IRON COUNTY, MICH.) ..SS
RECEIVED FOR RECORD THE 21ST DAY OF
FEBRUARY A.D. 19 95 AT
2:45 O'CLOCK P. M. AND RECORDED IN LIBER
6 OF L.C. RECORDS
ON PAGE 358
Mark Selms
DEPUTY REGISTER OF DEEDS

Register of Deeds Stamp & File Number

4. Lot No. _____, Recorded Plat _____
5. Private Claims _____

Quarter corner 20-21, T43N, R34W

I, Gary L. Pisoni, in a field survey on September 15, 19 94, do hereby certify that under requirements of P.A. 74, Michigan P.A. of 1970, the corner points mentioned in lines 1 and 2 above were in conformance with regulations and rules therefore as required in the current manual of survey instructions of the United States Department of the Interior, Bureau of Land Management or by a decree of a Court of Law and/or that the corner points mentioned in lines 3, 4 and 5 above were in conformance with the rules of the Michigan Board of Land Surveyors or by a Decree of a Court of Law; established, re-established, monumented, re-monumented, recovered, found as expressed below:

	A	B	C	D	E	F	G	H	I	J	K	L	M
2	6	5	4	3	2	1							
3													
4	7	8	9	10	11	12							
5													
6	16	17	16	15	14	13							
7													
8	19	20	21	22	23	24							
9													
10	30	29	28	27	26	25							
11													
12	31	32	33	34	35	36							
13													

NOTE: Not more than 4 corners, all in the same town and range, may be recorded on this certificate.

A. Description of original monument and accessories and/or subsequent restoration:

Original corner established by G.H. Carleton, U.S Deputy Surveyor in 1851.
Original corner: Wood Post
Original bearing trees:
 Yellow Birch 10" N 29°W 36 links (23.76 feet)
 Sugar 12" S 38½°E 10 links (6.6 feet)

B. Description of corner evidence found and/or method applied in restoring or reestablishing corner:

No evidence of original corner or bearing tree remains. Corner position found marked by a 5/8" x 30" iron pin and located in the centerline of an North/South county road. Corner position has been used and accepted as the corner locally for many years. Set an aluminum pipe monument over the top of the iron pin as described below. Monument is 6" below road bed surface.

This corner is accepted as the best available evidence of the position of the original corner.


County Record Research on file with County Representative office.

PEER GROUP APPROVED
Gary L. Pisoni
COUNTY REPRESENTATIVE
A.P. 11-30-94

C. Description of monument for corner and accessories established to perpetuate locating the position of the corner:

At the corner position, I set a 2" diameter by 30" long split base aluminum pipe monument with a 3" cast aluminum cap, stamped to read: Iron County Remonumentation, T43N, R34W, 1/4, S-20, S-21, 1994, RLS- 27457 from which I established the following new blazed and scribed bearing trees: (all measurements taken to a nail in side of tree)

Jack Pine	12"	N 28°E	39.32 feet
Sugar Maple	10"	S 25°E	60.82 feet
Sugar Maple	8"	S 36°W	56.04 feet
Sugar Maple	10"	N 56°W	52.63 feet
Steel Sign Post		East	17.51 feet
Rebar	5/8" x 30"	West	33.03 feet

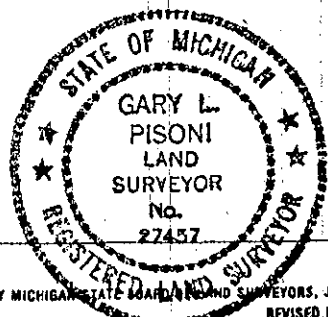

Signed by Gary L. Pisoni Date 1-9-95

Surveyor's Michigan License No. 27457