

SURVEY & REMONUMENTATION

MAR 19 1997

COMMISSION

LAND CORNER RECORDATION CERTIFICATE Filing Requirement of Act 74, Mich. P.A. 1970

For corners in _____
IRON
 (County)

Located In: _____ Corner Code # _____

1. Public Land Survey T 43N R 34W _____ F - 11
 T _____ R _____
 T _____ R _____
 T _____ R _____

2. Property Controlling in Section S _____ T _____ R _____
 S _____ T _____ R _____

3. Miscellaneous Property in Sec. S _____ T _____ R _____
 S _____ T _____ R _____

4. Lot No. _____, Recorded Plat _____

5. Private Claims _____

IRON COUNTY
MICHIGAN
RECEIVED FOR RECORD
96 APR 17 AM 8:26
L.C. Records L. 6, P. 430
Gerald W. Carlson
REGISTER OF DEEDS

Register of Deeds Stamp & File Number

I, GERALD W. CARLSON, in a field survey on AUGUST 30TH, 1995, do hereby state that under requirements of P.A. 74, Michigan P.A. of 1970, the corner points mentioned in lines 1 and 2 above were in conformance with regulations and rules therefore as required in the current manual of survey instructions of the United States Department of the Interior, Bureau of Land Management or by a decree of a Court of Law and/or that the corner points mentioned in lines 3, 4 and 5 above were in conformance with the rules of the Michigan Board of Land Surveyors or by a Decree of a Court of Law; established, re-established, monumented, recovered, found as expressed below:

A	B	C	D	E	F	G	H	I	J	K	L	M
1												
2	6	5	4	3	2	1						
3												
4	7	8	9	10	11	12						
5												
6	18	17	16	15	14	13						
7												
8	19	20	21	22	23	24						
9												
10	30	29	28	27	26	25						
11												
12	31	32	33	34	35	36						
13												

NOTE: Not more than 2 corners, all in the same town and range, may be recorded on this certificate.

A. Description of original monument and accessories and/or subsequent restoration:

- F-11: Quarter Corner common to Sections 28 and 33.
- 1851: Guy H. Carleton's subdivision notes describe the corner monument as a wood post referenced by:
- 18" Sugar Maple S35W, 25 links
- 14" Sugar Maple N40E, 26 links

Research on file with the Iron County Representative.

B. Description of corner evidence found and/or method applied in restoring or reestablishing corner:


No evidence of original corner or bearing trees found.

1995: Found a 2 1/2" outside diameter iron pipe marking the South 1/4 Corner of Section 28 being 3.5' long with a 1' long dead-man at the bottom at an old fence intersection North-South and East-West. The calculated straight line to the Southwest corner of Section 28 1/2 mile West lines up closely with found 2" iron pipes on the South line of the Plat of Earle (circa 1913). The found 2" iron pipe at the Southeast Corner of the Plat of Earle is 0.45' South of this calculated straight line. The distance East is 2635.74' and the distance West is 2616.64'.

PEER GROUP APPROVED
Iron County Representative 1-17-96
 COUNTY REPRESENTATIVE

C. Description of monument for corner and accessories established to perpetuate locating the position of the corner:

- 995: Replaced 2 1/2" o.d. pipe with a 2 1/2" diameter aluminum pipe capped with a 3 1/4" diameter aluminum tablet Iron County Remonumentation
- Monument stamped to identify the corner and referenced by 20d doublehead nails in:
 - 5" Maple N19E, 44.33'
 - 9" Maple N50E, 7.72'
 - 3" Maple S26E, 18.72'
 - 4" Cherry S47W, 23.17'
- Nail with survey marker sign N83W, 2.89'
- The monument is 0.55' above ground.
- k. 43-34-1, pg. 116
- ob No. 95-011

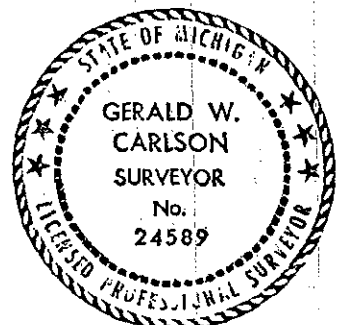

Signed by Gerald W. Carlson Date 6-12-96
 Surveyor's Michigan License No. 24589

L. 6 P. 430