

# SURVEY & REMONUMENTATION

MAR 19 1997

COMMISSION

## LAND CORNER RECORDATION CERTIFICATE Filing Requirement of Act 74, Mich. P.A. 1970

IRON COUNTY  
MICHIGAN  
RECEIVED FOR RECORD

96 APR 17 AM 8:26

L.C. Records L.6, P.431

*Eileen Stetson*  
REGISTER OF DEEDS

For corners in \_\_\_\_\_ Located In: \_\_\_\_\_ Corner Code # \_\_\_\_\_  
(County)

1. Public Land Survey T 43N R 34W \_\_\_\_\_ G - 11  
T \_\_\_\_\_ R \_\_\_\_\_  
T \_\_\_\_\_ R \_\_\_\_\_  
T \_\_\_\_\_ R \_\_\_\_\_

2. Property Controlling S \_\_\_\_\_ T \_\_\_\_\_ R \_\_\_\_\_  
in Section S \_\_\_\_\_ T \_\_\_\_\_ R \_\_\_\_\_

3. Miscellaneous S \_\_\_\_\_ T \_\_\_\_\_ R \_\_\_\_\_  
Property in Sec. S \_\_\_\_\_ T \_\_\_\_\_ R \_\_\_\_\_

4. Lot No. \_\_\_\_\_, Recorded Plat \_\_\_\_\_

5. Private Claims \_\_\_\_\_

Register of Deeds Stamp & File Number

	A	B	C	D	E	F	G	H	I	J	K	L	M
1													
2	6		5		4		3		2		1		
3													
4	7		8		9		10		11		12		
5													
6	18		17		16		15		14		13		
7													
8	19		20		21		22		23		24		
9													
10	30		29		28		27		26		25		
11													
12	31		32		33		34		35		36		
13													

I, GERALD W. CARLSON, in a field survey on AUGUST 30TH, 1995, do hereby state that under requirements of P.A. 74, Michigan P.A. of 1970, the corner points mentioned in lines 1 and 2 above were in conformance with regulations and rules therefore as required in the current manual of survey instructions of the United States Department of the Interior, Bureau of Land Management or by a decree of a Court of Law and/or that the corner points mentioned in lines 3, 4 and 5 above were in conformance with the rules of the Michigan Board of Land Surveyors or by a Decree of a Court of Law; established, re-established, monumented, recovered, found as expressed below:

NOTE: Not more than 2 corners, all in the same town and range, may be recorded on this certificate.

A. Description of original monument and accessories and/or subsequent restoration:

G-11: Section Corner common to Sections 27, 28, 33, and 34.  
1851: Guy H. Carleton's subdivision notes describe the corner monument as a wood post referenced by:  
20" Sugar Maple N53W, 22 links  
12" Sugar Maple S59E, 12 links

Research on file with the Iron County Representative.

B. Description of corner evidence found and/or method applied in restoring or reestablishing corner:

No evidence of original corner or bearing trees found.


1995: Found a 6" nail in road in line with old fences East and South. This nail was pointed out by Gary Pisoni, P.S. as being there and has been used by several surveyors as the corner. G. Pisoni indicated that this location checked well with his survey of Section 27. The distance North is 2683.84' and the distance West is 2635.74'.

PEER GROUP APPROVED

*Iron County Rep. Pisoni 1-17-96*  
COUNTY REPRESENTATIVE

C. Description of monument for corner and accessories established to perpetuate locating the position of the corner:

1995: Replaced 6" nail with a 2 1/2" diameter aluminum pipe capped with a 3 1/4" diameter aluminum tablet Iron County Remonumentation Monument stamped to identify the corner and referenced by 20d doublehead nails in:  
9" Maple N80W, 25.07'  
10" Maple N30W, 41.70'  
11" Maple N51E, 23.41'  
12" Maple S15W, 44.55'  
Rail with survey marker sign N81E, 33.00'  
The monument is located 0.5' West of the centerline of a woods road and at the intersection of a fence to the South extended North and a fence to the East extended West. The monument is set 0.55' below ground.  
bk. 43-34, pg. 118  
Job No. 95-011

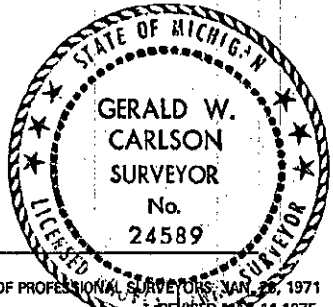

Signed by Gerald W. Carlson  
Surveyor's Michigan License No. 24589

Date 1-12-96

L.6 P.431