

MAR 9 2000

SECTION

LAND CORNER RECORDATION CERTIFICATE
Filing Requirement of Act 74, Mich. P.A. 1970

For corners in

Iron (County)	Located In:	Corner Code #
1. Public Land Survey	T 43N R 34W	1-5
	T ___ R ___	_____
	T ___ R ___	_____
	T ___ R ___	_____
2. Property Controlling in Section	S ___ T ___ R ___	_____
	S ___ T ___ R ___	_____
3. Miscellaneous Property in Sec.	S ___ T ___ R ___	_____
	S ___ T ___ R ___	_____

IRON COUNTY
MICHIGAN
RECEIVED FOR RECORD
99 DEC 30 AM 10:33
L.C. Records: L. 8, P. 132
Gary L. Pisoni
REGISTER OF DEEDS
Register of Deeds Stamp & File Number

4. Lot No. _____, Recorded Plat _____
5. Private Claims _____

Section Corner to Sections 10, 11, 14, 15, T43N, R34W

I, Gary L. Pisoni, in a field survey on Nov. 20, 1999 do hereby state that under requirements of P.A. 74, Michigan P.A. of 1970, the corner points mentioned in lines 1 and 2 above were in conformance with regulations and rules therefore as required in the current manual of survey instructions of the United States Department of the Interior, Bureau of Land Management or by a decree of a Court of Law and /or that the corner points mentioned in lines 3, 4 and 5 above were in conformance with the rules of the Michigan Board of Land Surveyors or by a Decree of a Court of Law; established, re-established, monumented, recovered, found as expressed below:

1	A	B	C	D	E	F	G	H	I	J	K	L	M
2		6		5		4		3		2		1	
3													
4		7		8		9		10		11		12	
5									●				
6		18		17		16		15		14		13	
7													
8		19		20		21		22		23		24	
9													
10		30		29		28		27		26		25	
11													
12		31		32		33		34		35		36	
13													

NOTE: Not more than 2 corners, all in the same town and range, may be recorded on this certificate.

A. Description of original monument and accessories and/or subsequent restoration:

Original corner established on September 2, 1851 by Guy H. Carleton, U.S. Deputy Surveyor.
Original Corner; Wood Post
Original Bearing Trees:
Lynn 16" S 15° E 32 lks (21.12 feet)
Sugar 10" N 25° W 52 lks (34.32 feet)

PEER GROUP APPROVED
Gary L. Pisoni 12-21-99
COUNTY REPRESENTATIVE


B. Description of corner evidence found and/or method applied in restoring or reestablishing corner:

No evidence of original B.T.s found.
At the corner position, found a 1 1/4" diameter iron pipe. Iron pipe has been used for many surveys in the surrounding area since the 1960's. I accept the iron pipe as the best available evidence for restoring the corner position.
Corner record research on file with County Representative.

C. Description of monument for corner and accessories established to perpetuate locating the position of the corner:

Inside the iron pipe, set a 5/8" diameter by 30" long rebar with a 3" diameter aluminum cap stamped as follows: Iron County Remonumentation, T43N, R34W, S-10, S-11, S-15, S-14, 1999, RLS 27457 from which I established the following new blazed and scribed bearing trees: (All measurements taken to a nail inside of tree)

Sugar Maple	9"	N 09° E	23.63 feet
Sugar Maple	14"	S 88° E	23.40 feet
Sugar Maple	16"	S 10° E	15.35 feet
Sugar Maple	18"	S 81° W	2.03 feet
Steel sign post		S 03° W	0.45 feet

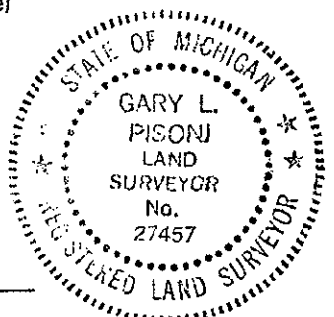

99-132
Signed by Gary L. Pisoni Date 12-28-99

Surveyor's Michigan License No. 27457

FORM APPROVED BY MICHIGAN STATE BOARD OF PROFESSIONAL SURVEYORS, JAN. 28, 1971
REVISED MAY 14, 1975
REVISED JAN. 1983
REVISED OCT., 1995