

1993

COMMISSION

LAND CORNER RECORDATION CERTIFICATE
Filing Requirement of Act 74, Mich. P.A. 1970

IRON COUNTY
MICHIGAN
RECEIVED FOR RECORD

93 DEC 29 PM 2:19
L.C. RECORDS L. 6 P. 283

Gilbert Stebbins
REGISTER OF DEEDS

For corners in

Iron
(County)

Located In:

Corner Code ~~##~~


| | | | | | |
|------------------------------------|---|------------|---|------------|------------|
| 1. Public Land Survey | T | <u>43N</u> | R | <u>34W</u> | <u>I-9</u> |
| | T | | R | | |
| | T | | R | | |
| | T | | R | | |
| 2. Property Controlling in Section | S | | T | R | |
| | S | | T | R | |
| 3. Miscellaneous Property in Sec. | S | | T | R | |
| | S | | T | R | |

Register of Deeds Stamp & File Number

- 4. Lot No. _____, Recorded Plat _____
- 5. Private Claims _____

Section Corner 22-23-26-27 T43N R34W

I, Gary L. Pisoni, in a field survey on December 17, 1993, do hereby certify that under requirements of P.A. 74, Michigan P.A. of 1970, the corner points mentioned in lines 1 and 2 above were in conformance with regulations and rules therefore as required in the current manual of survey instructions of the United States Department of the Interior, Bureau of Land Management or by a decree of a Court of Law and/or that the corner points mentioned in lines 3, 4 and 5 above were in conformance with the rules of the Michigan Board of Land Surveyors or by a Decree of a Court of Law; established, re-established, monumented, re-monumented, recovered, found as expressed below:

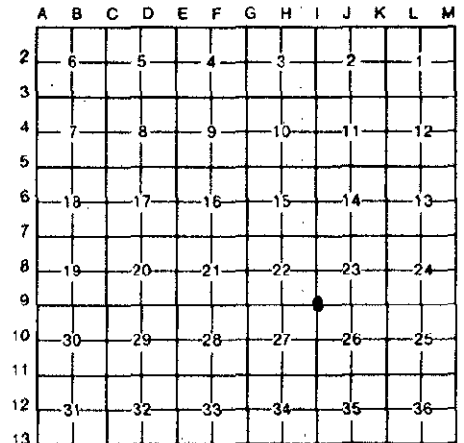

NOTE: Not more than 4 corners, all in the same town and range, may be recorded on this certificate.

A. Description of original monument and accessories and/or subsequent restoration:

Original corner established by Guy H. Carleton, U.S. Deputy Surveyor on August 31, 1851.
 Original corner: Wood Post
 Original bearing trees:

| | | | |
|-------------|-----|---------|-----------------------|
| Lynn | 20" | N 10° W | 11 links (7.26 feet) |
| Sugar Maple | 12" | S 70° E | 55 links (36.30 feet) |

B. Description of corner evidence found and/or method applied in restoring or reestablishing corner:

No evidence of original corner or bearing tree remains. Corner position found marked by a pointed Railroad Rail. Corner position has been used and accepted as the corner locally, for many years. Set an aluminum pipe monument at the corner position and reset Railroad Rail next to monument as described below. Monument located on East side of Helgemo County Road and along edge of tree line. Monument is 3" above ground surface.

This corner is accepted as the best available evidence of the position of the original corner.

C. Description of monument for corner and accessories established to perpetuate locating the position of the corner:

At the corner position, I set a 2" diameter by 30" long split base aluminum pipe monument with a 3" cast aluminum cap, stamped to read: Iron County Remonumentation, T43N, R34W, S-22, S-23, S-27, S-26, 1993, R.L.S. 27457; from which I established the following new blazed and scribed bearing trees: (all measurements taken to a nail in side of tree)

| | | | |
|-------------|-----|---------|------------|
| Sugar Maple | 8" | N 26° E | 41.53 feet |
| Basswood | 8" | N 46° E | 8.75 feet |
| Basswood | 7" | S 57° E | 3.56 feet |
| Sugar Maple | 10" | S 05° W | 24.59 feet |
| Steel rail | | N 58° W | 0.82 feet |

Signed by Gary L. Pisoni

Date 12-28-93

Surveyor's Michigan License No. 27457

