

SURVEY & REMONUMENTATION

JAN 19 1999

SECTION

LAND CORNER RECORDATION CERTIFICATE
Filing Requirement of Act 74, Mich. P.A. 1970

For corners in

Iron <small>(County)</small>	Located In:	Corner Code #
1. Public Land Survey	T <u>43N</u> R <u>R34W</u>	<u>K-9</u>
	T _____ R _____	_____
	T _____ R _____	_____
	T _____ R _____	_____
2. Property Controlling in Section	S _____ T _____ R _____	_____
	S _____ T _____ R _____	_____
3. Miscellaneous Property in Sec.	S _____ T _____ R _____	_____
	S _____ T _____ R _____	_____

IRON COUNTY
MICHIGAN
RECEIVED FOR RECORD
98 DEC 28 AM 11:10
L.C. Recorder: L. J. P. 236
G. J. P. 236
REGISTER OF DEEDS
Register of Deeds Stamp & File Number

4. Lot No. _____, Recorded Plat _____
 5. Private Claims _____

Section Corner Sections 23, 24, 25, 26, T43N, R34W

I, Gary L. Pisoni, in a field survey on October 20, 1998 do hereby state that under requirements of P.A. 74, Michigan P.A. of 1970, the corner points mentioned in lines 1 and 2 above were in conformance with regulations and rules therefore as required in the current manual of survey instructions of the United States Department of the Interior, Bureau of Land Management or by a decree of a Court of Law and /or that the corner points mentioned in lines 3, 4 and 5 above were in conformance with the rules of the Michigan Board of Land Surveyors or by a Decree of a Court of Law; established, re-established, monumented, recovered, found as expressed below:

1	A	B	C	D	E	F	G	H	I	J	K	L	M
2	6		5		4		3		2		1		
3													
4	7		8		9		10		11		12		
5													
6	18		17		16		15		14		13		
7													
8	19		20		21		22		23		24		
9													
10	30		29		28		27		26		25		
11													
12	31		32		33		34		35		36		
13													

NOTE: Not more than 2 corners, all in the same town and range, may be recorded on this certificate.

A. Description of original monument and accessories and/or subsequent restoration:

Original corner established in 1851 by Guy H. Carleton, U.S. Deputy Surveyor
 Original Corner; Wood Post
 Original Bearing Trees:
 Tamarack 14" N 70° W 35 lks (23.10 feet)
 Cedar 10" S 35° E 36 lks (23.76 feet)

B. Description of corner evidence found and/or method applied in restoring or reestablishing corner:

No evidence of original B.T.s found.
 Found an iron bar located at the corner position which has been in existence for over 30 years, and has been used for surveys in Sections 23, 24, 25, 26.
 Distances to adjoining corners are consistent with GLO distances.
 I accept the iron bar as the best available evidence for restoring the corner position.
 Corner record research on file with County Representative.


PEER GROUP APPROVED
Iron Co. Rep. 11-24-98
 COUNTY REPRESENTATIVE

C. Description of monument for corner and accessories established to perpetuate locating the position of the corner:

I replaced the iron bar with a 3/4" diameter aluminum rod monument 6' long and 6" above the ground surface with a 3" diameter aluminum cap stamped as follows: Iron County Remonumentation, T43N, R34W, S-23, S-24, S-25, S-26, 1998, RLS 27457 from which I established the following new blazed and scribed bearing trees: (All measurements taken to a nail in side of tree)

Ash	7"	S 81° E	22.21 feet
Ash	8"	S 42° W	13.46 feet
Ash	8"	N 52° W	21.06 feet
Steel sign post		S 22° W	0.80 feet

98-19
 Signed by Gary L. Pisoni Date 12-21-98
 Surveyor's Michigan License No. 27457

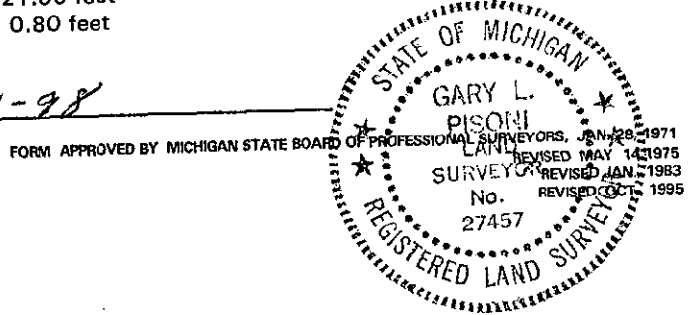

L. J. P. 236