

SURVEY & REMONUMENTATION

JAN 19 1999

SECTION

LAND CORNER RECORDATION CERTIFICATE
Filing Requirement of Act 74, Mich. P.A. 1970

For corners in

<u>Iron</u> (County)	Located In:	Corner Code #
1. Public Land Survey	T <u>43N</u> R <u>34W</u>	<u>M-9</u> ✓
	T <u>43N</u> R <u>33W</u>	<u>A-9</u>
	T _____ R _____	_____
	T _____ R _____	_____
2. Property Controlling in Section	S _____ T _____ R _____	_____
	S _____ T _____ R _____	_____
3. Miscellaneous Property in Sec.	S _____ T _____ R _____	_____
	S _____ T _____ R _____	_____

IRON COUNTY MICHIGAN
RECEIVED FOR RECORD

98 DEC 28 AM 11:11
L.C. Records: L. 7, P. 238

Gary L. Pisoni
REGISTERED LAND SURVEYOR

Register of Deeds Stamp & File Number

4. Lot No. _____, Recorded Plat _____
5. Private Claims _____

Section Corner Sections 24 and 25, T43N, R34W
Section Corner Sections 19 and 30, T43N, R33W

I, Gary L. Pisoni, in a field survey on October 20, 1998 do hereby state that under requirements of P.A. 74, Michigan P.A. of 1970, the corner points mentioned in lines 1 and 2 above were in conformance with regulations and rules therefore as required in the current manual of survey instructions of the United States Department of the Interior, Bureau of Land Management or by a decree of a Court of Law and /or that the corner points mentioned in lines 3, 4 and 5 above were in conformance with the rules of the Michigan Board of Land Surveyors or by a Decree of a Court of Law; established, re-established, monumented, recovered, found as expressed below:

1	A	B	C	D	E	F	G	H	I	J	K	L	M
2		6		5		4		3		2		1	
3													
4		7		8		9		10		11		12	
5													
6		18		17		16		15		14		13	
7													
8		19		20		21		22		23		24	
9													
10		30		29		28		27		26		25	
11													
12		31		32		33		34		35		36	
13													

NOTE: Not more than 2 corners, all in the same town and range, may be recorded on this certificate.

A. Description of original monument and accessories and/or subsequent restoration:

Original corner established in 1846 by Austin Burt, U.S. Deputy Surveyor
Original Corner; Sugar Post
Original Bearing Trees:
Hemlock 8" S 32 1/2° E 52 lks (34.32 feet)
Sugar 12" N 64° W 32 lks (21.12 feet)
Original Subdivision established by Guy H. Carleton, Deputy Surveyor in Sept. 1851.
Original Bearing Trees:
Sugar 10" N 65° E 50 lks (33.00 feet)
Sugar 10" S 25° W 51 lks (33.66 feet)

On 11-6-72, Arthur O. Enger, RLS with Michigan Dept. Of Natural Resources restored the corner position by single proportionate measurement. He set a 4" diameter aluminum capped pipe monument 10" above the ground, stamped as follows: DNR, T43N, R34W, R33W, S-19, S-24, S-25, S-30, 1972, RLS 13581, recorded in L.C. certificate, Liber 1, Pages 281-282 on July 31, 1974.

1972 Bearing Trees:
Sugar Maple 7" N 25° W 8.3 feet
Sugar Maple 5" N 69° E 13.6 feet
Sugar Maple 6" S 27° E 20.1 feet
Sugar Maple 6" S 15° W 12.1 feet
Sugar Maple 6" N 68° W 2.8 feet

B. Description of corner evidence found and/or method applied in restoring or reestablishing corner:


No evidence of original B.T.s found.
Found monument as set by Arthur O. Enger in 1972 and the following bearing trees:
Sugar Maple 10" N 24° W 8.26 feet
Sugar Maple 7" N 74° E 13.75 feet
Sugar Maple 8" S 25° E 20.22 feet
Sugar Maple 8" S 16° W 12.24 feet
Corner record research on file with county representative.

PEER GROUP APPROVED
Gary L. Pisoni 12-21-98
COUNTY REPRESENTATIVE

C. Description of monument for corner and accessories established to perpetuate locating the position of the corner:
New Reference Object set: Steel sign post N 46° E 0.81 feet

98-21
Signed by Gary L. Pisoni Date 12-21-98
Surveyor's Michigan License No. 27457

FORM APPROVED BY MICHIGAN STATE BOARD OF PROFESSIONAL SURVEYORS, JAN. 28, 1971
LAND SURVEYOR REVISED MAY 24, 1975
REVISED JAN., 1983
REVISED OCT., 1995

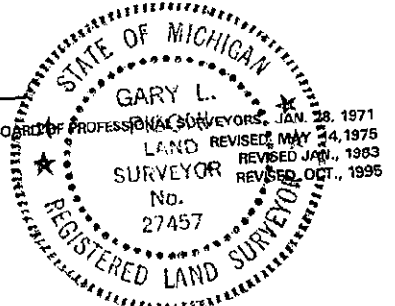

L. 7 P. 238