

LAND CORNER RECORDATION CERTIFICATE
Filing Requirement of Act 74, Mich. P.A. 1970

For corners in

<u>Iron</u> (County)	Located In:	Corner Code #
1. Public Land Survey	T <u>43N</u> R <u>35W</u>	<u>C-8</u>
	T _____ R _____	_____
	T _____ R _____	_____
	T _____ R _____	_____
2. Property Controlling in Section	S _____ T _____ R _____	_____
	S _____ T _____ R _____	_____
3. Miscellaneous Property in Sec.	S _____ T _____ R _____	_____
	S _____ T _____ R _____	_____

REGISTERS OFFICE)
 IRON COUNTY, MICH.) ..SS
 RECEIVED FOR RECORD THE 21ST DAY OF
FEBRUARY A.D. 19 95 AT
2:45 O'CLOCK P. M. AND RECORDED IN LIBER
6 OF L.C. RECORDS
 ON PAGE 370
Mark Schmitz
 DEPUTY REGISTER OF DEEDS

Register of Deeds Stamp & File Number

4. Lot No. _____, Recorded Plat _____
 5. Private Claims _____

Quarter Corner S-19, S-20, T43N, R35W

I, Gary L. Pisoni, in a field survey on October 19, 19 94
do hereby certify that under requirements of P.A. 74, Michigan P.A. of 1970, the corner points mentioned in lines 1 and 2 above were in conformance with regulations and rules therefore as required in the current manual of survey instructions of the United States Department of the Interior, Bureau of Land Management or by a decree of a Court of Law and/or that the corner points mentioned in lines 3, 4 and 5 above were in conformance with the rules of the Michigan Board of Land Surveyors or by a Decree of a Court of Law; established, re-established, monumented, re-monumented, recovered, found as expressed below:

A	B	C	D	E	F	G	H	I	J	K	L	M
2	6	5	4	3	2	1						
3												
4	7	8	9	10	11	12						
5												
6	16	17	16	15	14	13						
7												
8	19	20	21	22	23	24						
9												
10	30	29	28	27	26	25						
11												
12	31	32	33	34	35	36						
13												

NOTE: Not more than 4 corners, all in the same town and range, may be recorded on this certificate.

A. Description of original monument and accessories and/or subsequent restoration:

Original corner established by Harvey Mellen, U.S Deputy Surveyor in 1851.
 Original corner: Wood Post
 Original bearing trees:
 Elm 20" N 38°W 22 links (14.52 feet)
 Sugar 10" S 24°E 25 links (16.50 feet)

B. Description of corner evidence found and/or method applied in restoring or reestablishing corner:

No evidence of original corner or bearing tree remains. Corner position re-established by using the centerline of a county road which runs North and South and a fence line which runs West. Corner position has been used and accepted as the corner locally for many years. Corner position checks within reason to GLO distance from other GLO corners North and South. Set an aluminum pipe monument 6" below road bed surface as described below.

This corner position is accepted as the best available evidence of the position of the original corner.


County Record Research on file with County Representative office.

PEER GROUP APPROVED
 By: Iron Gary L. Pisoni
 COUNTY REPRESENTATIVE

C. Description of monument for corner and accessories established to perpetuate locating the position of the corner: AP 11-30-94

At the corner position, I set a 2" diameter by 30" long split base aluminum pipe monument with a 3" cast aluminum cap, stamped to read: Iron County Remonumentation, T43N, R35W, 1/4, S-19, S-20, 1994, RLS- 27457 from which I established the following new blazed and scribed bearing trees: (all measurements taken to a nail in side of tree)

Basswood	12" DbL.	N 60°W	87.08 feet
Balsam	5"	N 59°E	29.08 feet
Black Spruce	5"	S 61°E	26.10 feet
Rebar	5/8" x 30"	S 27°W	46.32 feet
Steel Sign Post		West	20.75 feet

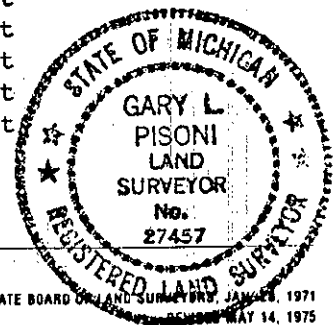

Signed by Gary L. Pisoni Date 1-9-95
 Surveyor's Michigan License No. 27457