

1993

COMMISSION

LAND CORNER RECORDATION CERTIFICATE  
Filing Requirement of Act 74, Mich. P.A. 1970

IRON COUNTY MICHIGAN  
RECEIVED FOR RECORD

93 DEC 29 PM 2:19  
L.C. RECORDS L. C. P. 280

*Gilbert Stebbins*  
REGISTER OF DEEDS

For corners in

Iron (County)	Located In:	Corner Code #
1. Public Land Survey	T <u>43N</u> R <u>35W</u>	<u>E-10</u>
	T _____ R _____	_____
	T _____ R _____	_____
	T _____ R _____	_____
2. Property Controlling in Section	S _____ T _____ R _____	_____
	S _____ T _____ R _____	_____
3. Miscellaneous Property in Sec.	S _____ T _____ R _____	_____
	S _____ T _____ R _____	_____
4. Lot No. _____, Recorded Plat _____		
5. Private Claims _____		

Register of Deeds Stamp & File Number

Quarter Corner 29-28 T43N R35W

I, Gary L. Pisoni, in a field survey on December 17, 19 93, do hereby certify that under requirements of P.A. 74, Michigan P.A. of 1970, the corner points mentioned in lines 1 and 2 above were in conformance with regulations and rules therefore as required in the current manual of survey instructions of the United States Department of the Interior, Bureau of Land Management or by a decree of a Court of Law and/or that the corner points mentioned in lines 3, 4 and 5 above were in conformance with the rules of the Michigan Board of Land Surveyors or by a Decree of a Court of Law; established, re-established, monumented, re-monumented, recovered, found as expressed below:

	A	B	C	D	E	F	G	H	I	J	K	L	M
2	6	5	4	3	2	1							
3													
4	7	8	9	10	11	12							
5													
6	18	17	16	15	14	13							
7													
8	19	20	21	22	23	24							
9													
10	30	29	28	27	26	25							
11													
12	31	32	33	34	35	36							
13													

**NOTE: Not more than 4 corners, all in the same town and range, may be recorded on this certificate.**

A. Description of original monument and accessories and/or subsequent restoration:

Original corner established by Harvey Mellen, U.S. Deputy Surveyor in 1851.  
Original corner: Wood Post  
Original bearing trees:

Hemlock	20"	N 65° E	41 links (27.06 feet)
Hemlock	14"	N 89° W	54 links (35.64 feet)

B. Description of corner evidence found and/or method applied in restoring or reestablishing corner:


No evidence of original corner or bearing tree remains. Corner position found marked by a 1" X 30" Iron pipe. Corner position has been used and accepted locally, for many years. Set an aluminum pipe monument over the top of iron pipe as described below. Monument located on fence line running South and centerline of County Road running North and West. Monument is 3" above ground surface.

This corner is accepted as the best available evidence of the position of the original corner.

C. Description of monument for corner and accessories established to perpetuate locating the position of the corner:

At the corner position, I set a 2" diameter by 30" long split base aluminum pipe monument with a 3" cast aluminum cap, stamped to read: Iron County Remonumentation, T43N, R35W, 1/4, S-29, S-28, 1993, R.L.S. 27457; from which I established the following new blazed and scribed bearing trees: (all measurements taken to a nail in side of tree)

Power Pole	WMPC N631914	N 16° E	73.12 feet
Spruce	6"	S 09° W	22.34 feet
Power Pole	N67 1040	N 71° W	87.95 feet
Power Pole	N67 1038	N 17° W	93.95 feet
Steel sign post		S 58° E	0.66 feet

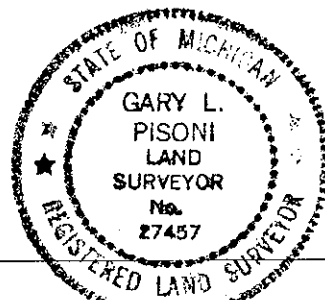

Signed by Gary L. Pisoni Date 12-28-93  
Surveyor's Michigan License No. 27457