

SURVEY & REMONUMENTATION

JAN 19 1999

SECTION

LAND CORNER RECORDATION CERTIFICATE
Filing Requirement of Act 74, Mich. P.A. 1970

For corners in

_____ Iron _____ (County)	Located In:	Corner Code #
1. Public Land Survey	T <u>43N</u> R <u>35W</u>	<u>E-11</u>
	T _____ R _____	_____
	T _____ R _____	_____
	T _____ R _____	_____
2. Property Controlling in Section	S _____ T _____ R _____	_____
	S _____ T _____ R _____	_____
3. Miscellaneous Property in Sec.	S _____ T _____ R _____	_____
	S _____ T _____ R _____	_____

IRON COUNTY MICHIGAN
 RECEIVED FOR RECORD
 98 DEC 28 AM 11:22
L.C. Register L. 7, P. 298
[Signature]
 Register of Deeds Stamp & File Number

4. Lot No. _____, Recorded Plat _____
 5. Private Claims _____

Section Corner Sections 28, 29, 32, and 33, T43N, R35W

I, Gary L. Pisoni, in a field survey on Nov. 17, 1998 do hereby state that under requirements of P.A. 74, Michigan P.A. of 1970, the corner points mentioned in lines 1 and 2 above were in conformance with regulations and rules therefore as required in the current manual of survey instructions of the United States Department of the Interior, Bureau of Land Management or by a decree of a Court of Law and /or that the corner points mentioned in lines 3, 4 and 5 above were in conformance with the rules of the Michigan Board of Land Surveyors or by a Decree of a Court of Law; established, re-established, monumented, recovered, found as expressed below:

	A	B	C	D	E	F	G	H	I	J	K	L	M
1													
2	6		5		4		3		2		1		
3													
4	7		8		9		10		11		12		
5													
6	18		17		16		15		14		13		
7													
8	19		20		21		22		23		24		
9													
10	30		29		28		27		26		25		
11													
12	31		32		33		34		35		36		
13													

NOTE: Not more than 2 corners, all in the same town and range, may be recorded on this certificate.

A. Description of original monument and accessories and/or subsequent restoration:

Original corner established in 1851 by Harvey Mellen, U.S. Deputy Surveyor.
 Original Corner; Wood Post
 Original Bearing Trees:
 Yellow Birch 14" S 33° W 13 links (8.58 feet)
 Yellow Birch 20" N 61° E 36 links (23.76 feet)

B. Description of corner evidence found and/or method applied in restoring or reestablishing corner:

No evidence of original B.T.s found. Found a 60 penny spike marking corner position, 2" below asphalt surface, located in the centerline of an East/West county road and in the centerline of a county road running South and in line with a rock fence line running North.

Distances to adjoining corners are consistent with GLO distances.

I accept the 60 penny spike as the best available evidence for restoring the corner position.

PERMITS APPROVED
[Signature]
 COUNTY REPRESENTATIVE


Corner record research on file with County Representative.

C. Description of monument for corner and accessories established to perpetuate locating the position of the corner:

From the above described corner position, I set two reference monuments, being a 5/8" diameter by 30" long rebar, with a 3" aluminum cap stamped as follows:
 Iron County Remonumentation, T43N, R35W, R.M., S-28, S-29, S-32, S-33, N 51° W, 51.25', 1998, RLS 27457,
 T43N, R35W, R.M., S-28, S-29, S-32, S-33, N 45° E, 40.47', 1998, RLS 27457 from which I blazed and scribed the following new bearing trees: (All measurements taken to a nail in side of tree)
 Utility Pole #75-0682 N 43° W 38.57 feet
 Utility Pole #98-08027 N 57° E 51.63 feet
 R.M. 5/8" x 30" rebar S 51° E 51.25 feet
 R.M. 5/8" x 30" rebar S 45° W 40.47 feet
 Steel sign post S 45° W 41.5 feet

98-146
 Signed by *[Signature]* Date 12-21-98
 Surveyor's Michigan License No. 27457

FORM APPROVED BY MICHIGAN STATE BOARD OF PROFESSIONAL SURVEYORS, JUN. 28, 1971
 NO. 27457
 REVISED MAY 14, 1975
 REVISED JAN., 1983
 REVISED OCT., 1995

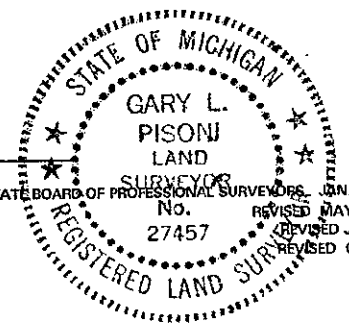

L. 7 P. 298