

JOB NUMBER: 94314
SHEET NO. : 1-552

FEB 27 1996

LAND CORNER RECORDATION CERTIFICATE
Filing Requirement of Act 74, Mich. P.A. 1970

IRON COUNTY
MICHIGAN
RECEIVED FOR RECORD
95 JAN 30 PM 3:51
L.C. RECORDS L.6 P. 338-339
Gilbert Stebbins
REGISTER OF DEEDS

For corners in

<u>IRON</u> (County)	Located In:	Corner Code #
1. Public Land Survey	T 42N R 35W	E-1
	T <u>43N</u> R <u>35W</u>	<u>E-13</u>
	T _____ R _____	_____
	T _____ R _____	_____
2. Property Controlling in Section	S _____ T _____ R _____	_____
	S _____ T _____ R _____	_____
3. Miscellaneous Property in Sec.	S _____ T _____ R _____	_____
	S _____ T _____ R _____	_____

Register of Deeds Stamp & File Number

- 4. Lot No. _____, Recorded Plat _____
- 5. Private Claims _____

A	B	C	D	E	F	G	H	I	J	K	L	M
2	6	5	4	3	2	1						
3												
4	7	8	9	10	11	12						
5												
6	18	17	16	15	14	13						
7												
8	19	20	21	22	23	24						
9												
10	30	29	28	27	26	25						
11												
12	31	32	33	34	35	36						
13												

I, GERALD W. CARLSON, in a field survey on Thursday, December 29, 1994, do hereby certify that under requirements of P.A. 74, Michigan P.A. of 1970, the corner points mentioned in lines 1 and 2 above were in conformance with regulations and rules therefore as required in the current manual of survey instructions of the United States Department of the Interior, Bureau of Land Management or by a decree of a Court of Law and/or that the corner points mentioned in lines 3, 4 and 5 above were in conformance with the rules of the Michigan Board of Land Surveyors or by a Decree of a Court of Law; established, re-established, monumented, re-monumented, recovered, found as expressed below:

NOTE: Not more than 4 corners, all in the same town and range, may be recorded on this certificate.

A. Description of original monument and accessories and/or subsequent restoration:

E-1: Section Corner Common to Sections 32 and 33, T43N-R35W and Sections 4 and 5, T42N-R35W.
 1846: John Burt's original survey notes describe the corner monument as a Spruce post referenced by:
 8" Cedar North 48 l
 8" Cedar N75W 30 l

1851: GLO subdivision survey notes indicate additional references:
 10" Tamarack S67E 12 l
 7" Cedar S63W 38 l

B. Description of corner evidence found and/or method applied in restoring or reestablishing corner:

1994: Found a 1 1/8" diameter 3.7' long iron pipe in swamp. Stream call to East measures 8' short of GLO record. Additional GLO line calls to top of ridges 18 chains and 20 chains to the East check well. As does the "enter swamp" line call 17 chains East.


(SEE REVERSE SIDE FOR SKETCH)

PEER GROUP APPROVED

Iron *Harry P. Person*
COUNTY REPRESENTATIVE
H.P. 1-25-95

C. Description of monument for corner and accessories established to perpetuate locating the position of the corner:

1994: Replaced 1 1/8" diameter pipe with a 3/4" diameter 7.0' long aluminum rod capped with a 3 1/4" diameter aluminum tablet marked Iron County Remonumentation and stamped to identify the corner referenced by nails in:
 14" Tamarack N31W 17.76 ft.
 6" Maple N55E 29.22 ft.
 7" Cedar S55E 38.22 ft.
 7" Balsam S50W 36.94 ft.
 Rail with Survey Marker sign S20E 0.96 ft.
 Monument is 0.25' above ground.

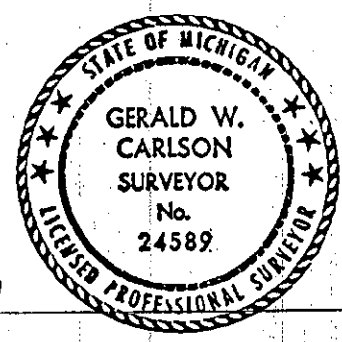

Signed by Gerald W. Carlson
Surveyor's Michigan License No. 24589

Date 12-30-94