

LAND CORNER RECORDATION CERTIFICATE
Filing Requirement of Act 74, Mich. P.A. 1970

For corners in

<u>Iron</u> (County)	Located In:	Corner Code #
1. Public Land Survey	T 43N R 35W	G-2
	T _____ R _____	_____
	T _____ R _____	_____
	T _____ R _____	_____
2. Property Controlling in Section	S _____ T _____ R _____	_____
	S _____ T _____ R _____	_____
3. Miscellaneous Property in Sec.	S _____ T _____ R _____	_____
	S _____ T _____ R _____	_____
4. Lot No. _____, Recorded Plat _____		
5. Private Claims _____		

REGISTRAR'S OFFICE)
 IRON COUNTY, MICH.) ..SS
 RECEIVED FOR RECORD THE 21ST DAY OF
FEBRUARY A.D. 19 95 AT
2:45 O'CLOCK P M., AND RECORDED IN LIBER
6 OF L.C. RECORDS
 ON PAGE 357
Mark Wilson
 DEPUTY REGISTER OF DEEDS
Register of Deeds Stamp & File Number

Quarter corner 4-3 T43N R35W

I, Gary L. Pisoni, in a field survey on September 13, 19 94, do hereby certify that under requirements of P.A. 74, Michigan P.A. of 1970, the corner points mentioned in lines 1 and 2 above were in conformance with regulations and rules therefore as required in the current manual of survey instructions of the United States Department of the Interior, Bureau of Land Management or by a decree of a Court of Law and/or that the corner points mentioned in lines 3, 4 and 5 above were in conformance with the rules of the Michigan Board of Land Surveyors or by a Decree of a Court of Law: established, re-established, monumented, re-monumented, recovered, found as expressed below:

A	B	C	D	E	F	G	H	I	J	K	L	M
2	6	5	4	3	2							
3												
4	7	8	9	10	11	12						
5												
6	18	17	16	15	14	13						
7												
8	19	20	21	22	23	24						
9												
10	30	29	28	27	26	25						
11												
12	31	32	33	34	35	36						
13												

NOTE: Not more than 4 corners, all in the same town and range, may be recorded on this certificate.

A. Description of original monument and accessories and/or subsequent restoration:

Original corner established by Harvey Mellen, U.S. Deputy Surveyor in 1851.
 Original corner: Wood Post
 Original bearing trees:
 White Pine 18" S 70°W 4 links (2.64 feet)
 Hemlock 14" N 41°E 21 links (13.86 feet)

B. Description of corner evidence found and/or method applied in restoring or reestablishing corner:


No evidence of original corner or bearing tree remains. Corner position found marked by a 5/8" x 17" rebar, set by Gerald W. Carlson RLS #24589 from a section sub-division of Section 3. Corner set by single proportionate measurement and on line between the Northwest and Southwest section corners of Section 3. Set an aluminum pipe monument over the top of rebar pin as described below. Monument is 3" above ground surface. This corner is accepted as the best available evidence of the position of the original corner.
 County Record Research on file with County Representative office.

PEER GROUP APPROVED
Iron Gary L. Pisoni
 COUNTY REPRESENTATIVE
 A.P. 11-30-94

C. Description of monument for corner and accessories established to perpetuate locating the position of the corner:

At the corner position, I set a 2" diameter by 30" long split base aluminum pipe monument with a 3" cast aluminum cap, stamped to read: Iron County Remonumentation, T43N, R35W, 1/4, S-4, S-3, 1994, RLS 27457; from which I established the following new blazed and scribed bearing trees: (all measurements taken to a nail in side of tree)

(Existing) Aspen	6"	S 19°E	3.62 feet
" Cherry	5"	N 46°E	11.37 feet
" Red Pine	7"	N 75°W	56.97 feet
" White Spruce	13"	N 26°E	67.52 feet
Steel Sign Post		East	1.01 feet

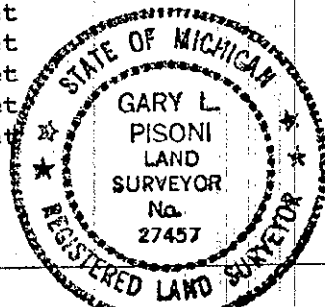

Signed by Gary L. Pisoni Date: 1-9-95
 Surveyor's Michigan License No. 27457