

1993

COMMISSION LAND CORNER RECORDATION CERTIFICATE
Filing Requirement of Act 74, Mich. P.A. 1970

IRON COUNTY MICHIGAN
RECEIVED FOR RECORD
93 DEC 29 PM 2:19
L.C. RECORDS L. C. P. 272
Gilbert Stiles
REGISTER OF DEEDS

For corners in Iron (County)
Located In: _____ Corner Code # _____

1. Public Land Survey	T <u>43N</u> R <u>35W</u>	<u>G-6</u>
	T _____ R _____	_____
	T _____ R _____	_____
	T _____ R _____	_____
2. Property Controlling in Section	S _____ T _____ R _____	_____
	S _____ T _____ R _____	_____
3. Miscellaneous Property in Sec.	S _____ T _____ R _____	_____
	S _____ T _____ R _____	_____

4. Lot No. _____, Recorded Plat _____
5. Private Claims _____

Register of Deeds Stamp & File Number

	A	B	C	D	E	F	G	H	I	J	K	L	M
2	6	5	4	3	2	1							
3													
4	7	8	9	10	11	12							
5													
6	18	17	16	15	14	13							
7													
8	19	20	21	22	23	24							
9													
10	30	29	28	27	26	25							
11													
12	31	32	33	34	35	36							
13													

Quarter Corner 16-15 T43N R35W

I, Gary L. Pisoni, in a field survey on December 16, 19 93, do hereby certify that under requirements of P.A. 74, Michigan P.A. of 1970, the corner points mentioned in lines 1 and 2 above were in conformance with regulations and rules therefore as required in the current manual of survey instructions of the United States Department of the Interior, Bureau of Land Management or by a decree of a Court of Law and/or that the corner points mentioned in lines 3, 4 and 5 above were in conformance with the rules of the Michigan Board of Land Surveyors or by a Decree of a Court of Law; established, re-established, monumented, re-monumented, recovered, found as expressed below:

NOTE: Not more than 4 corners, all in the same town and range, may be recorded on this certificate.

A. Description of original monument and accessories and/or subsequent restoration:

Original corner established by Harvey Mellen, U.S. Deputy Surveyor in 1851.
Original corner: Wood Post
Original bearing trees:
Sugar Maple 10" S 10° W 30 links (19.80 feet)
Sugar Maple 14" East 13 links (8.58 feet)

B. Description of corner evidence found and/or method applied in restoring or reestablishing corner:


No evidence of original corner or bearing tree remains. Corner position found marked by a 3/4" X 18" iron pin. Corner position has been used and accepted as the corner locally, for many years. Set an aluminum pipe monument over the top of iron pin as described below. Monument is flush with ground surface.

This corner is accepted as the best available evidence of the position of the original corner.

C. Description of monument for corner and accessories established to perpetuate locating the position of the corner:

At the corner position, I set a 2" diameter by 30" long split base aluminum pipe monument with a 3" cast aluminum cap, stamped to read: Iron County Remonumentation, T43N, R35W, 1/4, S-16, S-15, 1993, R.L.S. 27457; from which I established the following new blazed and scribed bearing trees: (all measurements taken to a nail in side of tree)

White Spruce	5"	N 25° E	47.52 feet
Utility Pole		S 80° E	69.62 feet
White Pine	30" db1	S 09° E	23.11 feet
Rebar	5/8"x30"	S 53° W	15.63 feet
Steel sign post		S 13° W	1.17 feet

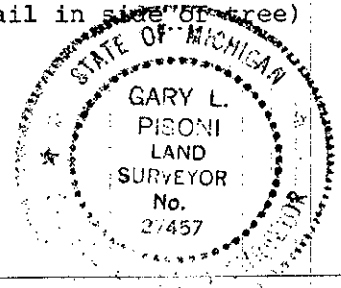

Signed by Gary L. Pisoni Date 12-28-93

Surveyor's Michigan License No. 27457