

SUB-DIV & RE-MONUMENTATION

1993

COMMISSION

LAND CORNER RECORDATION CERTIFICATE
Filing Requirement of Act 74, Mich. P.A. 1970

IRON COUNTY MICHIGAN
RECEIVED FOR RECORD

93 DEC 29 PM 2:22
L.C. RECORDS L. 6 P. 307

Gilbert Stebbins
REGISTER OF DEEDS

For corners in

Iron (County)	Located In:	Corner Code #
1. Public Land Survey	T 43N R 35W	H-7
	T _____ R _____	_____
	T _____ R _____	_____
	T _____ R _____	_____
2. Property Controlling in Section	S _____ T _____ R _____	_____
	S _____ T _____ R _____	_____
3. Miscellaneous Property in Sec.	S _____ T _____ R _____	_____
	S _____ T _____ R _____	_____
4. Lot No. _____, Recorded Plat _____		
5. Private Claims _____		

Register of Deeds Stamp & File Number

Quarter Corner 15-22 T43N R35W

I, Gary L. Pisoni, in a field survey on December 21, 19 93, do hereby certify that under requirements of P.A. 74, Michigan P.A. of 1970, the corner points mentioned in lines 1 and 2 above were in conformance with regulations and rules therefore as required in the current manual of survey instructions of the United States Department of the Interior, Bureau of Land Management or by a decree of a Court of Law and/or that the corner points mentioned in lines 3, 4 and 5 above were in conformance with the rules of the Michigan Board of Land Surveyors or by a Decree of a Court of Law; established, re-established, monumented, re-monumented, recovered, found as expressed below:

	A	B	C	D	E	F	G	H	I	J	K	L	M
2	6		5		4		3		2		1		
3													
4	7		8		9		10		11		12		
5													
6	18		17		16		15		14		13		
7													
8	19		20		21		22		23		24		
9													
10	30		29		28		27		26		25		
11													
12	31		32		33		34		35		36		
13													

NOTE: Not more than 4 corners, all in the same town and range, may be recorded on this certificate.

A. Description of original monument and accessories and/or subsequent restoration:

Original corner established by Harvey Mellen, U.S. Deputy Surveyor in 1851.
Original corner: Wood Post
Original bearing trees:
Sugar Maple 9" S 51° W 27 links (17.82 feet)
Yellow Birch 9" N 39° E 33 links (21.78 feet)


B. Description of corner evidence found and/or method applied in restoring or reestablishing corner:

No evidence of original corner or bearing tree remains. Corner position found marked by a 1" diameter iron pin encased in a concrete slab set by Iron Ore Mining Companies in the 1950's. Monument located along East side of a North-South woods road.

This corner is accepted as the best available evidence of the position of the original corner.

C. Description of monument for corner and accessories established to perpetuate locating the position of the corner:

From the above corner monument, I established the following new corner references:
(all measurements taken to a nail in side of tree, or to a reference object)
Red Maple 6" N 46° E 31.99 feet
Popple 6" S 60° E 31.13 feet
Red Maple (clump) 4" S 55° W 57.00 feet
Rebar 5/8"x30" North 11.43 feet
Steel Sign Post East 2.00 feet

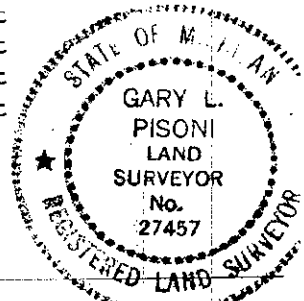

Signed by *Gary L. Pisoni*

Date 12-28-93

Surveyor's Michigan License No. 27457