

LAND CORNER RECORDATION CERTIFICATE
Filing Requirement of Act 74, Mich. P.A. 1970

For corners in

<u>Iron</u> (County)	Located In:	Corner Code #
1. Public Land Survey	T <u>43N</u> R <u>35W</u>	<u>K-5</u>
	T _____ R _____	_____
	T _____ R _____	_____
	T _____ R _____	_____
2. Property Controlling in Section	S _____ T _____ R _____	_____
	S _____ T _____ R _____	_____
3. Miscellaneous Property in Sec.	S _____ T _____ R _____	_____
	S _____ T _____ R _____	_____
4. Lot No. _____, Recorded Plat _____		
5. Private Claims _____		

REGISTERS OFFICE)
 IRON COUNTY, MICH.) ..SS
 RECEIVED FOR RECORD THE 21ST DAY OF
FEBRUARY A.D. 19 95 AT
2:45 O'CLOCK P. M. AND RECORDED IN LIBER
6 OF LC RECORDS
 ON PAGE 367
Mark Selnes
 DEPUTY REGISTER OF DEEDS
 Register of Deeds Stamp & File Number

Section Corner 11, 12, 14, 13, T43N, R35W

I, Gary L. Pisoni, in a field survey on October 18, 1994
do hereby certify that under requirements of P.A. 74, Michigan P.A. of 1970, the corner points mentioned
in lines 1 and 2 above were in conformance with regulations and rules therefore as required in the
current manual of survey instructions of the United States Department of the Interior, Bureau of Land
Management or by a decree of a Court of Law and/or that the corner points mentioned in lines 3, 4 and 5
above were in conformance with the rules of the Michigan Board of Land Surveyors or by a Decree of a
Court of Law; established, re-established, monumented, re-monumented, recovered, found as
expressed below:

**NOTE: Not more than 4 corners, all in the same town and range, may be recorded
on this certificate.**

A. Description of original monument and accessories and/or subsequent restoration:

Original corner established by Harvey Mellen, U.S Deputy Surveyor in 1851.
 Original corner: Wood Post
 Original bearing trees:
 Spruce 14" S 80°W 14 links (9.24 feet)
 Spruce 14" N 34°E 22 links (14.52 feet)

B. Description of corner evidence found and/or method applied in restoring or reestablishing corner:


No evidence of original corner or bearing tree remains. Corner position found marked
by an iron pipe and located in the centerline of a North/South county road and in
line with the centerline of a county road running West. Corner position has been
used and accepted as the corner locally for many years. Set an aluminum pipe monument
over the top of iron pipe as described below. Monument is 6" below road bed surface.
This corner is accepted as the best available evidence of the position of the
original corner.
County Record Research on file with County Representative office.

PEER GROUP APPROVED
Iron County Henry J. Porru
 COUNTY REPRESENTATIVE

C. Description of monument for corner and accessories established to perpetuate locating the position of the corner: A.P. 11-30-94

At the corner position, I set a 2" diameter by 30" long split base aluminum pipe
monument with a 3" cast aluminum cap, stamped to read: Iron County Remonumentation,
T43N, R35W, S-11, S-12, S-14, S-13, 1994, RLS- 27457 from which I established the
following new blazed and scribed bearing trees: (all measurements taken to a nail
in side of tree)

Tamarack	12"	S 34°W	64.09 feet
Rebar	5/8" x 30"	N 54°W	61.56 feet
Black Spruce	9" DbL.	N 37°W	76.31 feet
Utility Pole		N 49°E	35.48 feet
Rebar	5/8" x 30"	S 42°E	39.23 feet
Steel Sign Post		East	21.78 feet

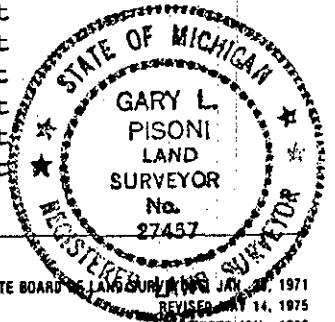

Signed by Henry J. Porru Date 1-9-95

Surveyor's Michigan License No. 27457

FORM APPROVED BY MICHIGAN STATE BOARD OF LAND SURVEYORS JAN. 1971
 REVISED MAY 14, 1975
 REVISED JAN., 1983