

1993

COMMISSION

LAND CORNER RECORDATION CERTIFICATE
Filing Requirement of Act 74, Mich. P.A. 1970

IRON COUNTY MICHIGAN
RECEIVED FOR RECORD

93 DEC 29 PM 2:20

L.C. RECORDS L. C. P. 285

Gilbert Stobie
REGISTER OF DEEDS

For corners in

Iron
(County)

Located In: Corner Code #

1. Public Land Survey	T 43N R 35W	L-5
	T _____ R _____	_____
	T _____ R _____	_____
	T _____ R _____	_____
2. Property Controlling in Section	S _____ T _____ R _____	_____
	S _____ T _____ R _____	_____
3. Miscellaneous Property in Sec.	S _____ T _____ R _____	_____
	S _____ T _____ R _____	_____

Register of Deeds Stamp & File Number

4. Lot No. _____, Recorded Plat _____
5. Private Claims _____

Quarter Corner 12-13 T43N R35W

I, Gary L. Pisoni, in a field survey on December 17, 19 93, do hereby certify that under requirements of P.A. 74, Michigan P.A. of 1970, the corner points mentioned in lines 1 and 2 above were in conformance with regulations and rules therefore as required in the current manual of survey instructions of the United States Department of the Interior, Bureau of Land Management or by a decree of a Court of Law and/or that the corner points mentioned in lines 3, 4 and 5 above were in conformance with the rules of the Michigan Board of Land Surveyors or by a Decree of a Court of Law; established, re-established, monumented, re-monumented, recovered, found as expressed below:

NOTE: Not more than 4 corners, all in the same town and range, may be recorded on this certificate.

	A	B	C	D	E	F	G	H	I	J	K	L	M
2	6		5		4		3		2		1		
3													
4	7		8		9		10		11		12		
5													
6	18		17		16		15		14		13		
7													
8	19		20		21		22		23		24		
9													
10	30		29		28		27		26		25		
11													
12	31		32		33		34		35		36		
13													

A. Description of original monument and accessories and/or subsequent restoration:

Original corner established by Harvey Mellen, U.S. Deputy Surveyor in 1851.
Original corner: Wood Post
Original bearing trees:
Sugar Maple 10" N 87° E 26 links (17.16 feet)
White Pine 28" N 72° W 15 links (9.90 feet)

B. Description of corner evidence found and/or method applied in restoring or reestablishing corner:


No evidence of original corner or bearing tree remains. Corner position found marked by a 1" X 30" iron pipe. Corner position has been used and accepted locally, for many years. Set an aluminum pipe monument over the top of iron pipe as described below. Monument is 2" below ground surface of old woods road.

This corner is accepted as the best available evidence of the position of the original corner.

C. Description of monument for corner and accessories established to perpetuate locating the position of the corner:

At the corner position, I set a 2" diameter by 30" long split base aluminum pipe monument with a 3" cast aluminum cap, stamped to read: Iron County Remonumentation, T43N, R35W, 1/4, S-12, S-13, 1993, R.L.S. 27457; from which I established the following new blazed and scribed bearing trees: (all measurements taken to a nail in side of tree)

Rebar	5/8"x30"	N 70° E	18.60 feet
Rebar	5/8"x30"	S 12° E	29.38 feet
White Birch	11"	S 79° W	34.08 feet
White Birch	7"	N 23° W	55.46 feet
Steel sign post		N 63° E	7.97 feet

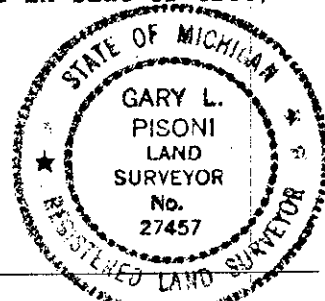

Signed by Gary L. Pisoni Date 12-28-93

Surveyor's Michigan License No. 27457