

**SURVEY &
REMONUMENTATION**

JAN 19 1999

LAND CORNER RECORDATION CERTIFICATE
Filing Requirement of Act 74, Mich. P.A. 1970

SECTION

For corners in

| | | |
|---------------------------------------|---------------------------|---------------|
| Iron <small>(County)</small> | Located In: | Corner Code # |
| 1. Public Land Survey | T <u>43N</u> R <u>35W</u> | <u>L-7</u> |
| | T _____ R _____ | _____ |
| | T _____ R _____ | _____ |
| | T _____ R _____ | _____ |
| 2. Property Controlling in Section | S _____ T _____ R _____ | _____ |
| | S _____ T _____ R _____ | _____ |
| 3. Miscellaneous Property in Sec. | S _____ T _____ R _____ | _____ |
| | S _____ T _____ R _____ | _____ |

IRON COUNTY
MICHIGAN
RECEIVED FOR RECORD

98 DEC 28 AM 11:14
L.C. Record: L. 7, P. 254

Register of Deeds Stamp & File Number

4. Lot No. _____, Recorded Plat _____
5. Private Claims _____

Quarter Corner Sections 13 and 24, T43N, R35W

I, Gary L. Pisoni, in a field survey on November 2, 1998 do hereby state that under requirements of P.A. 74, Michigan P.A. of 1970, the corner points mentioned in lines 1 and 2 above were in conformance with regulations and rules therefore as required in the current manual of survey instructions of the United States Department of the Interior, Bureau of Land Management or by a decree of a Court of Law and /or that the corner points mentioned in lines 3, 4 and 5 above were in conformance with the rules of the Michigan Board of Land Surveyors or by a Decree of a Court of Law; established, re-established, monumented, recovered, found as expressed below:

| | | | | | | | | | | | | | |
|----|----|---|---|----|---|---|----|---|---|----|---|----|----|
| | A | B | C | D | E | F | G | H | I | J | K | L | M |
| 1 | | | | | | | | | | | | | |
| 2 | 6 | | | 5 | | | 4 | | | 3 | | 2 | 1 |
| 3 | | | | | | | | | | | | | |
| 4 | 7 | | | 8 | | | 9 | | | 10 | | 11 | 12 |
| 5 | | | | | | | | | | | | | |
| 6 | 18 | | | 17 | | | 16 | | | 15 | | 14 | 13 |
| 7 | | | | | | | | | | | | | |
| 8 | 19 | | | 20 | | | 21 | | | 22 | | 23 | 24 |
| 9 | | | | | | | | | | | | | |
| 10 | 30 | | | 29 | | | 28 | | | 27 | | 26 | 25 |
| 11 | | | | | | | | | | | | | |
| 12 | 31 | | | 32 | | | 33 | | | 34 | | 35 | 36 |
| 13 | | | | | | | | | | | | | |

NOTE: Not more than 2 corners, all in the same town and range, may be recorded on this certificate.

A. Description of original monument and accessories and/or subsequent restoration:

Original corner established in August, 1851 by Harvey Mellen, Deputy Surveyor.
Original Corner; Wood Post
Original Bearing Trees:

| | | | |
|--------------|-----|---------|---------------------|
| Yellow Birch | 12" | N 25° E | 15 lks (9.90 feet) |
| Hemlock | 12" | S 55° E | 44 lks (29.04 feet) |

B. Description of corner evidence found and/or method applied in restoring or reestablishing corner:

No evidence of original B.T.s found.

Found a 4" diameter brass capped pipe monument in concrete, 4" above ground surface, located on a rock fence line running East and in line with the centerline of a County Road running North. Monument was set by local mining company and stamped as follows: T43N, R35W, 1/4, S-13, S-24.

I accept the above monument as the best available evidence for restoring the corner position.

Distances to the East and West are consistent with GLO distances.

Corner record research on file with County Representative.

PEER GROUP APPROVED
Gary L. Pisoni 11-24-98
COUNTY REPRESENTATIVE


C. Description of monument for corner and accessories established to perpetuate locating the position of the corner:

From the above described monument, blazed and scribed the following new bearing trees: (All measurements taken to a nail in side of tree)

| | | | |
|-----------------|-------|---------|------------|
| Maple | 8" | East | 51.65 feet |
| Maple | 8" | S 33° E | 23.24 feet |
| Utility Pole | #5-21 | N 81° W | 26.16 feet |
| Steel sign post | | South | 0.70 feet |

98-113
Signed by Gary L. Pisoni Date 12-21-98
Surveyor's Michigan License No. 27457

FORM APPROVED BY MICHIGAN STATE BOARD OF PROFESSIONAL SURVEYORS, JAN. 28, 1971
REVISED MAY 14, 1975
REVISED JAN., 1983
REVISED OCT., 1995

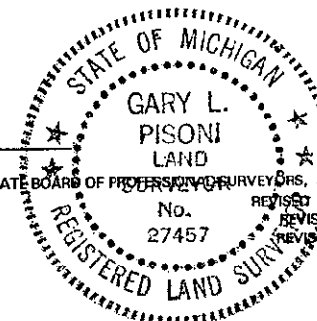

L. 7 P. 254