

**SURVEY &
REMONUMENTATION**

JAN 12 1996

COMMISSION

LAND CORNER RECORDATION CERTIFICATE
Filing Requirement of Act 74, Mich. P.A. 1970

IRON COUNTY
MICHIGAN
RECEIVED FOR RECORD

95 DEC 15 PM 2:21
LC Records L 6, P 406

Gilbert Stiebel
REGISTER OF DEEDS

For corners in

Iron

(County)

Located In:

Corner Code #

1. Public Land Survey

T 43N	R 34W	A-1
T 43N	R 35W	M-1
T 44N	R 35W	M-13
T 44N	R 34W	A-13

2. Property Controlling in Section

S _____ T _____ R _____

3. Miscellaneous Property in Sec.

S _____ T _____ R _____

4. Lot No. _____, Recorded Plat _____

5. Private Claims _____

Section Corner	S.36 T44N R35W	S.31 T44N R34W
	S. 1 T43N R35W	S. 6 T43N R34W

I, Gary L. Pisoni in a field survey on October 12, 19 95

do hereby certify that under requirements of P.A. 74, Michigan P.A. of 1970, the corner points mentioned in lines 1 and 2 above were in conformance with regulations and rules therefore as required in the current manual of survey instructions of the United States Department of the Interior, Bureau of Land Management or by a decree of a Court of Law and/or that the corner points mentioned in lines 3, 4 and 5 above were in conformance with the rules of the Michigan Board of Land Surveyors or by a Decree of a Court of Law; established, ~~re-established~~, monumented, re-monumented, recovered, found as expressed below:

NOTE: Not more than 4 corners, all in the same town and range, may be recorded on this certificate.

A. Description of original monument and accessories and/or subsequent restoration:

Original corner established by William A. Burt, U.S. Deputy Surveyor in 1847.

Original corner: Cedar Post

Original bearing trees:

Cedar	9"	S 28° E	34 links (22.44 feet)
Cedar	12"	N 41° W	40 links (26.40 feet)

B. Description of corner evidence found and/or method applied in restoring or reestablishing corner:

No original corner evidence found. Found wood post with rusty location tag on nearby cedar facing wood post. Wood post located at a fence corner. Fence lines running North, South, and East. GLO distances N-S-E-W check good to monumented section corners. I accept the wood post as the best available evidence for restoring the corner position.

Research on file with County Representative.

C. Description of monument for corner and accessories established to perpetuate locating the position of the corner:

At the corner position, I set a 3/4" outside diameter by 4 feet long aluminum rod monument with a 3" cast aluminum cap, stamped to read: Iron County Remonumentation, T44N, R35W, R34W, S-36, S-31, S-1, S-6, T43N- 1995, RLS-27457 from which I established the following new blazed and scribed bearing trees: (all measurements taken to a nail in side of tree)



Black Spruce	8"	N 44° W	4.20 feet
Cedar	17"	N 80° E	27.49 feet
Black Spruce	8"	S 34° W	15.30 feet
Cedar	13"	N 77° W	35.42 feet
Cedar	14"	S 62° E	5.00 feet
Steel Sign Post		North	0.87 feet


Date 11-30-95

Surveyor's Michigan License No. 27457

PEER GROUP APPROVED
Iron Amy L. Pisoni 12-14-95
COUNTY REPRESENTATIVE

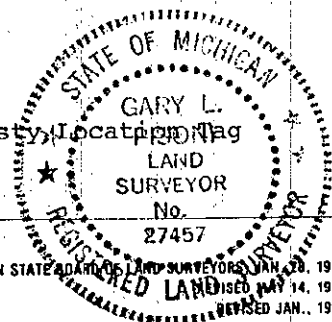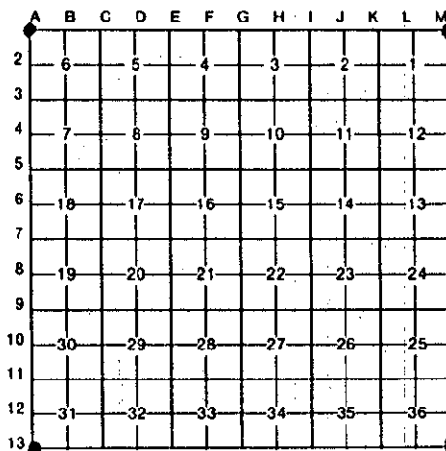

FORM APPROVED BY MICHIGAN STATE BOARD OF LAND SURVEYORS, JAN. 28, 1971
REVISED MAY 14, 1975
REVISED JAN., 1983