

REMONUMENTATION

FEB 22 1996

COMMISSION

LAND CORNER RECORDATION CERTIFICATE
Filing Requirement of Act 74, Mich. P.A. 1970

IRON COUNTY MICHIGAN
RECEIVED FOR RECORD

93 DEC 29 PM 2:19

L.C. RECORDS L.C. P. 275

Gilbert Stobie
REGISTER OF DEEDS

For corners in

Iron
(County)

Located In:

Corner Code #


1. Public Land Survey	T 43N R 35W	M-5
	T 43N R 34W	A-5
	T R	
	T R	
2. Property Controlling in Section	S T R	
	S T R	
3. Miscellaneous Property in Sec.	S T R	
	S T R	

Register of Deeds Stamp & File Number

- 4. Lot No. _____, Recorded Plat _____
- 5. Private Claims _____

Section Corner 12-7-13-18 T43N R35-34W

I, Gary L. Pisoni, in a field survey on December 16, 19 93, do hereby certify that under requirements of P.A. 74, Michigan P.A. of 1970, the corner points mentioned in lines 1 and 2 above were in conformance with regulations and rules therefore as required in the current manual of survey instructions of the United States Department of the Interior, Bureau of Land Management or by a decree of a Court of Law and/or that the corner points mentioned in lines 3, 4 and 5 above were in conformance with the rules of the Michigan Board of Land Surveyors or by a Decree of a Court of Law; established, re-established, monumented, re-monumented, recovered, found as expressed below:

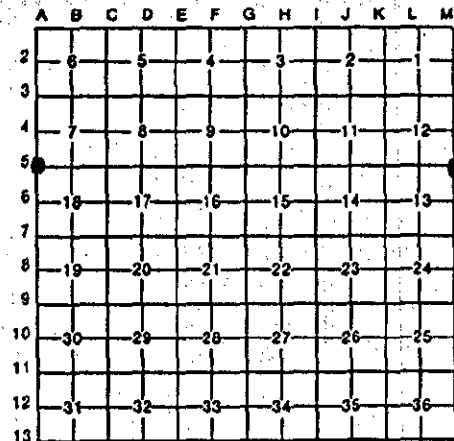

NOTE: Not more than 4 corners, all in the same town and range, may be recorded on this certificate.

A. Description of original monument and accessories and/or subsequent restoration:

Original Corner established by William A. Burt, U.S. Deputy Surveyor on September 11, 1846.
 Original corner: Hemlock, 8"
 Original bearing trees:

Hemlock	16"	N 28° W	11 links (7.26 feet)
Hemlock	16"	N 85° E	25 links (16.50 feet)
Hemlock	20"	S 30° W	37 links (24.42 feet)

B. Description of corner evidence found and/or method applied in restoring or reestablishing corner:


No evidence of original corner or bearing trees remains. Corner position found marked by a 2" X 24" iron pipe. Corner position has been used and accepted as the corner locally, for many years. Layed iron pipe next to aluminum monument as described below. Monument is 3" above ground surface.

This corner is accepted as the best available evidence of the position of the original corner.

C. Description of monument for corner and accessories established to perpetuate locating the position of the corner:

At the corner position, I set a 2" diameter by 30" long split base aluminum pipe monument with a 3" cast aluminum cap, stamped to read: Iron County Remonumentation, T43N, R35W, R34W, S-12, S-7, S-13, S-18, 1993, R.L.S. 27457; from which I established the following new blazed and scribed bearing trees: (all measurements taken to a nail in side of tree)

Rebar	5/8"x30"	N 47° E	21.66 feet
Red Maple	7" clump	S 15° W	27.60 feet
Red Maple	8" clump	S 64° W	32.08 feet
Rebar	5/8"x30"	N 09° W	21.30 feet
Steel rail		N 50° W	1.38 feet

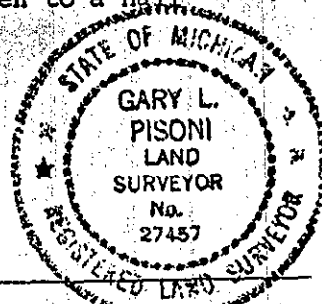

Signed by Gary L. Pisoni Date 12-28-93

Surveyor's Michigan License No. 27457