

REMONUMENTATION

FEB 22 1996

COMMISSION

For corners in

Iron  
(County)

Located In:

Corner Code #

- 1. Public Land Survey
 

T	<u>43N</u>	<u>R35W</u>	<u>M-6</u>
T	<u>43N</u>	<u>R34W</u>	<u>A-6</u>
T			
T			
- 2. Property Controlling in Section
 

S		T		R	
S		T		R	
- 3. Miscellaneous Property in Sec.
 

S		T		R	
S		T		R	
- 4. Lot No. \_\_\_\_\_, Recorded Plat \_\_\_\_\_
- 5. Private Claims \_\_\_\_\_

IRON COUNTY MICHIGAN RECEIVED FOR RECORD

93 DEC 29 PM 2:20

L.C. RECORDS L.C. P. 289

*Gilbert Stebbins*  
REGISTER OF DEEDS

Register of Deeds Stamp & File Number

Quarter Corner 13-18 T43N R35-34W

I, Gary L. Pisoni, in a field survey on December 18, 19 93 do hereby certify that under requirements of P.A. 74, Michigan P.A. of 1970, the corner points mentioned in lines 1 and 2 above were in conformance with regulations and rules therefore as required in the current manual of survey instructions of the United States Department of the Interior, Bureau of Land Management or by a decree of a Court of Law and/or that the corner points mentioned in lines 3, 4 and 5 above were in conformance with the rules of the Michigan Board of Land Surveyors or by a Decree of a Court of Law; established, re-established, monumented, re-monumented, recovered, found as expressed below:

	A	B	C	D	E	F	G	H	I	J	K	L	M
2	6	5	4	3	2	1							
3													
4	7	8	9	10	11	12							
6													
6	18	17	16	15	14	13							
7													
8	19	20	21	22	23	24							
9													
10	30	29	28	27	26	25							
11													
12	31	32	33	34	35	36							
13													

NOTE: Not more than 4 corners, all in the same town and range, may be recorded on this certificate.

A. Description of original monument and accessories and/or subsequent restoration:

Original corner established by William Burt, U.S. Deputy Surveyor on September 11, 1846.  
 Original corner: Sugar Post  
 Original bearing trees:

Sugar Maple	8"	N 19° E	28 links (18.48 feet)
Sugar Maple	4"	N 54° W	15 links ( 9.90 feet)

B. Description of corner evidence found and/or method applied in restoring or reestablishing corner:


No evidence of original corner or bearing tree remains. Corner position found marked by a 5/8" X 32" iron pin. Iron pin located on an old fence line running East, West, and North. Corner position has been used and accepted as the corner locally, for many years. Set an aluminum pipe monument over the top of iron pin as described below. Monument is 1" above ground surface.

This corner is accepted as the best available evidence of the position of the original corner.

C. Description of monument for corner and accessories established to perpetuate locating the position of the corner:

At the corner position, I set a 2" diameter by 30" long split base aluminum pipe monument with a 3" cast aluminum cap, stamped to read: Iron County Remonumentation, T43N, R35W, R34W, 1/4, S-13, S-18, 1993, R.L.S. 27457; from which I established the following new blazed and scribed bearing trees: (all measurements taken to a nail in side of tree)

Sugar Maple	6"	N 26° E	28.75 feet
Sugar Maple	7"	N 76° E	51.51 feet
Sugar Maple	7"	S 60° E	20.11 feet
Sugar Maple	8"	S 36° W	28.77 feet
Steel rail		East	0.84 feet

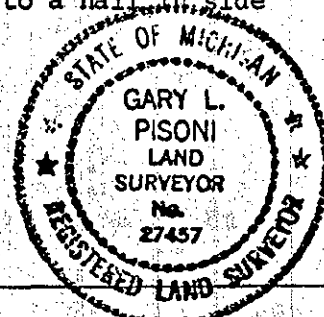

Signed by Gary L. Pisoni

Date 12-28-93

Surveyor's Michigan License No. 27457