

SURVEY & REMONUMENTATION

JAN 13 1998

SECTION

LAND CORNER RECORDATION CERTIFICATE Filing Requirement of Act 74, Mich. P.A. 1970

For corners in

Iron
(County)

Located In:

Corner Code #

1. Public Land Survey

T 43N R 34 W

~~A-8~~
M-8

T 43N R 35W

T _____ R _____

T _____ R _____

2. Property Controlling
in Section

S _____ T _____ R _____

S _____ T _____ R _____

3. Miscellaneous
Property in Sec.

S _____ T _____ R _____

S _____ T _____ R _____

4. Lot No. _____, Recorded Plat _____

5. Private Claims _____

Quarter corner Section 19, T43N, R34W
Quarter corner Section 24, T43N, R35W

I, Gary L. Pisoni, in a field survey on November 28, 1997 do hereby state that under requirements of P.A. 74, Michigan P.A. of 1970, the corner points mentioned in lines 1 and 2 above were in conformance with regulations and rules therefore as required in the current manual of survey instructions of the United States Department of the Interior, Bureau of Land Management or by a decree of a Court of Law and/or that the corner points mentioned in lines 3, 4 and 5 above were in conformance with the rules of the Michigan Board of Land Surveyors or by a Decree of a Court of Law; established, re-established, monumented, recovered, found as expressed below:

NOTE: Not more than 2 corners, all in the same town and range, may be recorded on this certificate.

A. Description of original monument and accessories and/or subsequent restoration:

Original corner established in 1846 by WM A. Burt, U.S. Deputy Surveyor.

Original Corner; Yellow Birch Post

Original Bearing Trees;

Sugar
Y. Birch

8"
15"

N75° E
N72° 30'W

33 lks.(21.78 feet)
26 lks.(17.16 feet)

B. Description of corner evidence found and/or method applied in restoring or reestablishing corner:

No original corner evidence was recovered.

Corner found marked by a 2" diameter iron bar encased in concrete and set flush with the ground surface. Corner is located along the East edge of an abandoned county road and an old fence line running East. Iron bar has been used for many surveys in Sections 19 and 24. The distance along the Range Line checks very close to the GLO distance. I accept the iron bar as the best available evidence for restoring the corner position.

C. Description of monument for corner and accessories established to perpetuate locating the position of the corner:

N31°E, 2.88 feet from the corner position, set a Reference Monument which is a 5/8" x 30" Rebar, set 1" above the ground surface, with a 3 inch diameter aluminum cap stamped as follows; Iron County Remonumentation, T43N, R35W, R34W, R.M. 1/4, S24, S19, S31° W, 2.88', 1997, RLS 27457. Blazed and scribed the following bearing trees and tied them to the actual Quarter Corner position. (Measurements are taken to a nail in side of tree)

Sugar Maple	7"	N80°E	10.46 feet
Sugar Maple	11"	S34°W	53.37 feet
Sugar Maple	10"	N75°W	52.59 feet
Ref. Mon.	5/8"x30"	N31°E	2.88 feet
Steel Sign Post		N31°E	3.50 feet

97-53


Signed by

Gary L. Pisoni

Date November 29, 1997

Surveyor's Michigan License No. 27457

FORM APPROVED BY MICHIGAN STATE BOARD OF PROFESSIONAL SURVEYORS, JAN. 28, 1971

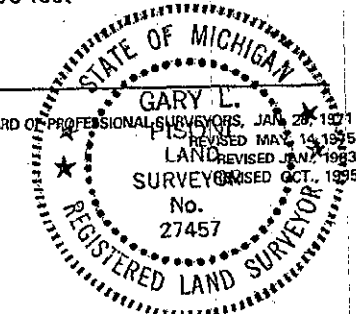

IRON COUNTY
MICHIGAN
RECEIVED FOR RECORD

97 DEC 23 PM 1:30

L.C. Records L.7 P.158

Gilbert Stetson
REGISTER OF DEEDS

Register of Deeds Stamp & File Number

	A	B	C	D	E	F	G	H	I	J	K	L	M
1													
2	6		5		4		3		2		1		
3													
4	7		8		9		10		11		12		
5													
6	18		17		16		15		14		13		
7													
8	19		20		21		22		23		24		
9													
10	30		29		28		27		26		25		
11													
12	31		32		33		34		35		36		
13													

PEER GROUP APPROVED

Gary L. Pisoni 12-1-97

IRON COUNTY REPRESENTATIVE