

**SURVEY &
REMONUMENTATION**

JAN 19 1999

SECTION

LAND CORNER RECORDATION CERTIFICATE
Filing Requirement of Act 74, Mich. P.A. 1970

For corners in

<u>Iron</u> (County)	Located In:	Corner Code #	
1. Public Land Survey	T <u>42N</u> R <u>34W</u>	<u>A-1</u>	
	T <u>42N</u> R <u>35W</u>	<u>M-1</u>	
	T <u>43N</u> R <u>34W</u>	<u>A-13</u>	
	T <u>43N</u> R <u>35W</u>	<u>M-13</u> ✓	
2. Property Controlling in Section	S ___ T ___ R ___	___	___
	S ___ T ___ R ___	___	___
3. Miscellaneous Property in Sec.	S ___ T ___ R ___	___	___
	S ___ T ___ R ___	___	___

IRON COUNTY
MICHIGAN
RECEIVED FOR RECORD

98 DEC 28 AM 11:30

L.C. Records: L. 7, P. 339

Robert Stiles

Register of Deeds Stamp & File Number

4. Lot No. _____, Recorded Plat _____
5. Private Claims _____

Section Corner Section 36, T43N, R35W; Section Corner Section 31, T43N, R34W
Section Corner Section 1, T42N, R35W; Section Corner Section 6, T42N, R34W

I, Gary L. Pisoni, in a field survey on Dec. 16, 1998 do hereby state that under requirements of P.A. 74, Michigan P.A. of 1970, the corner points mentioned in lines 1 and 2 above were in conformance with regulations and rules therefore as required in the current manual of survey instructions of the United States Department of the Interior, Bureau of Land Management or by a decree of a Court of Law and/or that the corner points mentioned in lines 3, 4 and 5 above were in conformance with the rules of the Michigan Board of Land Surveyors or by a Decree of a Court of Law; established, re-established, monumented, recovered, found as expressed below:

A	B	C	D	E	F	G	H	I	J	K	L	M
1												
2	6		5		4		3		2		1	
3												
4	7		8		9		10		11		12	
5												
6	18		17		16		15		14		13	
7												
8	19		20		21		22		23		24	
9												
10	30		29		28		27		26		25	
11												
12	31		32		33		34		35		36	
1												

NOTE: Not more than 2 corners, all in the same town and range, may be recorded on this certificate.

A. Description of original monument and accessories and/or subsequent restoration:

Original corner established in 1846, by William A. Burt, U.S. Deputy Surveyor.
Original Corner; Cedar Post
Original Bearing Trees:

Yellow Birch	12"	N 42 1/2° E	29 links (19.14 feet)
Cedar	12"	S 74° W	11 links (7.26feet)

PEER GROUP APPROVED
Iron Co. Representative 12-18-98
COUNTY REPRESENTATIVE

B. Description of corner evidence found and/or method applied in restoring or reestablishing corner:

No evidence of original B.T.s found. Found a 1" diameter iron bar encased in concrete marking corner position and located in the centerline of a county road to the East and the centerline line of Baker Road to the South. Corner position was set by the local mining company in the 1950's. I accept the iron bar in concrete as the best available evidence for restoring the corner position.

Corner record research on file with County Representative.

C. Description of monument for corner and accessories established to perpetuate locating the position of the corner:

From the above described corner position, I set a reference monument, being a 5/8" diameter by 30" long rebar, with a 3" diameter aluminum cap stamped as follows:
Iron County Remonumentation, T43N, R35W, R34W, R.M., S-36, S-31, S-1, S-6, South, 2.77', T42N, 1998, RLS 27457, from which I blazed and scribed the following new bearing trees: (All measurements taken to a nail in side of tree)

Popple	6"	S 20°W	36.94 feet
Popple	7"	S 85°W	10.31 feet
R.M.	5/8" x 30" rebar	North	2.77 feet
Steel sign post		North	3.37 feet


98-167

Signed by *Gary L. Pisoni*

Date 12-21-98

Surveyor's Michigan License No. 27457

FORM APPROVED BY MICHIGAN STATE BOARD OF PROFESSIONAL SURVEYORS, JAN. 28, 1971
REVISED MAY 14, 1975
REVISED JAN., 1983
REVISED OCT., 1995

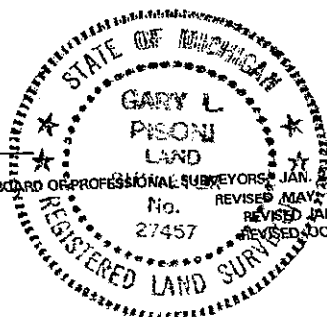

L. 7 P. 339