

1993

COMMISSION

LAND CORNER RECORDATION CERTIFICATE  
Filing Requirement of Act 74, Mich. P.A. 1970

IRON COUNTY,  
MICHIGAN  
RECEIVED FOR RECORD

93 DEC 29 PM 2: 19  
L.C. RECORDS L. 6 P. 274

*Gilbert Stiles*  
REGISTER OF DEEDS

For corners in

Iron (County)	Located In:	Corner Code ##
1. Public Land Survey	T 43N R 36W	K-2
	T _____ R _____	_____
	T _____ R _____	_____
	T _____ R _____	_____
2. Property Controlling in Section	S _____ T _____ R _____	_____
	S _____ T _____ R _____	_____
3. Miscellaneous Property in Sec.	S _____ T _____ R _____	_____
	S _____ T _____ R _____	_____
4. Lot No. _____, Recorded Plat _____		
5. Private Claims _____		

Register of Deeds Stamp & File Number

Quarter Corner 2-1 T43N R36W

I, Gary L. Pisoni, in a field survey on December 16, 19 93, do hereby certify that under requirements of P.A. 74, Michigan P.A. of 1970, the corner points mentioned in lines 1 and 2 above were in conformance with regulations and rules therefore as required in the current manual of survey instructions of the United States Department of the Interior, Bureau of Land Management or by a decree of a Court of Law and/or that the corner points mentioned in lines 3, 4 and 5 above were in conformance with the rules of the Michigan Board of Land Surveyors or by a Decree of a Court of Law; established, re-established, monumented, re-monumented, recovered, found as expressed below:

**NOTE: Not more than 4 corners, all in the same town and range, may be recorded on this certificate.**

	A	B	C	D	E	F	G	H	I	J	K	L	M
2	6	5	4	3	2	1							
3													
4	7	8	9	10	11	12							
5													
6	18	17	16	15	14	13							
7													
8	19	20	21	22	23	24							
9													
10	30	29	28	27	26	25							
11													
12	31	32	33	34	35	36							
13													

A. Description of original monument and accessories and/or subsequent restoration:

Original corner established by Martin M. Hall, U.S. Deputy Surveyor in 1851.  
Original corner: Wood Post  
Original bearing trees:

Cedar	16"	S 43°W	16 links (10.56 feet)
Spruce	18"	N 47°E	18 links (11.88 feet)


B. Description of corner evidence found and/or method applied in restoring or reestablishing corner:

No evidence of original corner or bearing tree remains. Corner position was re-established by Donald Lappala RLS, U.S. Forest Service on October 30, 1967, where he found a 1 1/2" X 48" iron pipe set by I.N. Woodworth RLS date unknown. Lappala replaced iron pipe with a 2" X 5' concrete filled galvanized pipe with a 3" bronze tablet. Said monument was bent and replaced with an aluminum pipe monument as described below. Monument is located on the West side of Cemetery County Road. Monument is flush with ground surface.

C. Description of monument for corner and accessories established to perpetuate locating the position of the corner:

At the corner position, I set a 2" diameter by 30" long split base aluminum pipe monument with a 3" cast aluminum cap, stamped to read: Iron County Remonumentation, T43N, R36W, 1/4, S-2, S-1, 1993, R.L.S. 27457; from which I established the following new blazed and scribed bearing trees: (all measurements taken to a nail in side of tree)

Red Pine	12"	N 72°E	57.52 feet
Utility Pole	#83-21317	S 64°E	43.35 feet
White Spruce	8"	S 41°W	7.50 feet
White Spruce	15"	N 36°W	20.21 feet
Steel rail		West	1.16 feet

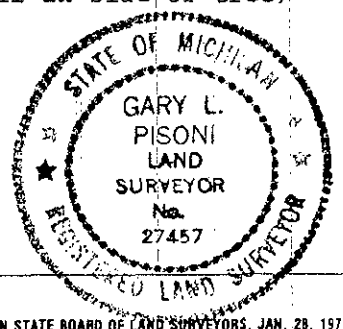

Signed by Gary L. Pisoni

Date 12-28-93

Surveyor's Michigan License No. 27457