

1993

COMMISSION

LAND CORNER RECORDATION CERTIFICATE
Filing Requirement of Act 74, Mich. P.A. 1970

IRON COUNTY MICHIGAN RECEIVED FOR RECORD

93 DEC 29 PM 2:20
L.C. RECORDS L.C. P. 290

Gileen Stebie
REGISTER OF DEEDS

For corners in

Iron (County)	Located In:	Corner Code #
1. Public Land Survey	T <u>43N</u> R <u>36W</u>	<u>K-4</u>
	T _____ R _____	_____
	T _____ R _____	_____
	T _____ R _____	_____
2. Property Controlling in Section	S _____ T _____ R _____	_____
	S _____ T _____ R _____	_____
3. Miscellaneous Property in Sec.	S _____ T _____ R _____	_____
	S _____ T _____ R _____	_____
4. Lot No. _____, Recorded Plat _____		
5. Private Claims _____		

Register of Deeds Stamp & File Number

Quarter Corner 11-12 T43N R36W

I, Gary L. Pisoni, in a field survey on December 18, 19 93, do hereby certify that under requirements of P.A. 74, Michigan P.A. of 1970, the corner points mentioned in lines 1 and 2 above were in conformance with regulations and rules therefore as required in the current manual of survey instructions of the United States Department of the Interior, Bureau of Land Management or by a decree of a Court of Law and/or that the corner points mentioned in lines 3, 4 and 5 above were in conformance with the rules of the Michigan Board of Land Surveyors or by a Decree of a Court of Law, established, re-established, monumented, re-monumented, recovered, found as expressed below:

	A	B	C	D	E	F	G	H	I	J	K	L	M
2	6	5	4	3	2	1							
3													
4	7	8	9	10	11	12							
5													
6	18	17	16	15	14	13							
7													
8	19	20	21	22	23	24							
9													
10	30	29	28	27	26	25							
11													
12	31	32	33	34	35	36							
13													

NOTE: Not more than 4 corners, all in the same town and range, may be recorded on this certificate.

A. Description of original monument and accessories and/or subsequent restoration:

Original corner established by Martin M. Hall, U.S. Deputy Surveyor in 1851.
Original corner: Wood Post
Original bearing trees:
Sugar Maple 16" N 67°W 17 links (11.22 feet)
Yellow Birch 24" S 50°E 46 links (30.36 feet)


B. Description of corner evidence found and/or method applied in restoring or reestablishing corner:

No evidence of original corner or bearing tree remains. Corner position was re-established by the U.S. Forest Service on November 1, 1967 as recorded in Liber 4, page 10 of Land Corner Certificates. Found 36" Drill Rod as described in above recorded certificate. Set an aluminum pipe monument over the top of drill rod as described below. Monument is located in the centerline of a County Road. Monument is 4" below ground surface.

C. Description of monument for corner and accessories established to perpetuate locating the position of the corner:

At the corner position, I set a 2" diameter by 30" long split base aluminum pipe monument with a 3" cast aluminum cap, stamped to read: Iron County Remonumentation, T43N, R36W, 1/4, S-11, S-12, 1993, R.L.S. 27457; from which I established the following new blazed and scribed bearing trees: (all measurements taken to a nail in side of tree)

Ref. Mon	2" brass capped iron pipe	S 88°W	30.71 feet
Rebar	5/8"x30"	N 19°E	29.04 feet
Rebar	5/8"x30"	S 20°E	27.01 feet
White Spruce	9"	S 27°W	31.95 feet
Sugar Maple	13"	N 27°W	79.18 feet
Steel rail		East	10.64 feet

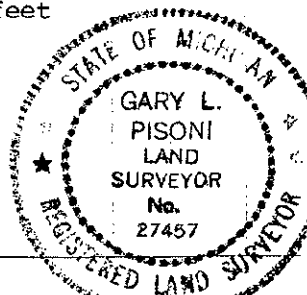

Signed by Gary L. Pisoni Date 12-28-93

Surveyor's Michigan License No. 27457