LAND CORNER RECORDATION CERTIFICATE
Filing Requirement of Act 74, Mich. P.A. 1970

For corners in
Iron
(County)

	Located In:			Corner Code #
1. Public Land Survey		T 44N	R 31W	K1
		T___	R___	
		T___	R___	
		T___	R___	
2. Property Controlling in Section	S___	T___	R___	
	S___	T___	R___	
3. Miscellaneous Property in Sec.	S___	T___	R___	
	S___	T___	R___	

Register of Deeds Stamp & File Number

4. Lot No. _____ , Recorded Plat _____
5. Private Claims _____

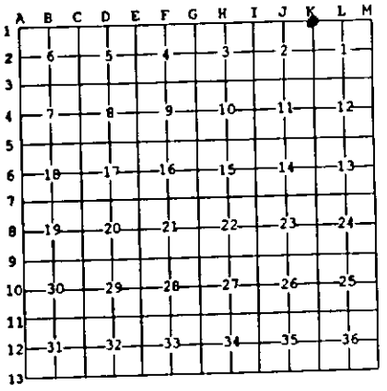

Apr 25 1995

I, Stephan J. Szyszkoski, in a field survey on _____, 19___ do hereby state that under requirements of P.A. 74, Michigan P.A. of 1970, the corner points mentioned in lines 1 and 2 above were in conformance with regulations and rules therefore as required in the current manual of survey instructions of the United States Department of the Interior, Bureau of Land Management or by a decree of a Court of Law and /or that the corner points mentioned in lines 3, 4 and 5 above were in conformance with the rules of the Michigan Board of Land Surveyors or by a Decree of a Court of Law; established, re-established, monumented, recovered, found as expressed below:

NOTE: Not more than 2 corners, all in the same town and range, may be recorded on this certificate.

A. Description of original monument and accessories and/or subsequent restoration:
(K1) Corner common to Sections 1-2 T44N-R31W and 35-36 T45N-R31W. Corner reestablished by proportionate measurement in 1968 by A.O. Enger: "Corner re-established by proportionate measurement between township corner 80.014 chains east and 1/4 corner 40.007 chains west. Found no evidence of original corner or its accessories or any replacement monuments or accessories, but did find a 10" black spruce with blazes on four sides distant N4W 71 links from corner set here. Set 1" I.D. x 36" iron pipe with 4" aluminum cap. Witnesses to corner: Bl. spruce 4 N84W 24.5 links, Bl. Spruce 8 N07E 44.5 links".

B. Description of corner evidence found and/or method applied in restoring or reestablishing corner:
(K1) Recovered the 1968 monument as described, a 1" I.D. iron pipe capped with a 4" dia. cast aluminum Mich. Dept. of Natural Resources tablet, now broken. The monument was found leaning slightly out of position. I replumbed the monument, and made firm, resetting it to fit the 1968 accessories, which were both recovered. The Spruce NW is now dead and down. The NE Spruce is in good condition. Made three new witnesses as described below. Monument recovered and rewitnessed by S.Szyszkoski and M.Roose, Baraga District Office. Found distance west to 1/4 corner to be 2638.6'. Did not measure to the east. The blazed black spruce noted above in part A was not recovered.

C. Description of monument for corner and accessories established to perpetuate locating the position of the corner:
(K1) Found 1" iron pipe with broken 4" aluminum MDNR tablet. Blazed and scribed the following:
2" Spruce S10E 28.1' "S1 NBT"
3" Spruce S32W 39.6' "S2 NBT"
3" R. Pine N44W 53.7' "S35 NBT"
The 1968 wit: Bl Spruce N10E 29.4'
Corner falls in a plantation. Bearings are magnetic.

STATE OF MICHIGAN
STEPHAN J. SZYSZKOSKI
LAND SURVEYOR
No. 33986
LICENSED LAND SURVEYOR

Signed by Stephan J. Szyszkoski Date 12/30/97
Surveyor's Michigan License No. 33986

For the Michigan Department of Natural Resources - Forest Management Division

FORM APPROVED BY MICHIGAN STATE BOARD OF PROFESSIONAL SURVEYORS, JAN. 26, 1971
REVISED MAY 14, 1975
REVISED JAN., 1983
REVISED OCT., 1995