

LAND CORNER RECORDATION CERTIFICATE
Filing Requirement of Act 74, Mich. P.A. 1970 as Amended

For corners in

<u>Iron</u> (County)	Located In:	Corner Code #
1. Public Land Survey	T _____ R _____	_____
	T _____ R _____	_____
2. Property Controlling in Section	S 4 T 44N R 31W	F2
	S 4 T 44N R 31W	13
3. Miscellaneous Property in Sec.	S _____ T _____ R _____	_____
	S _____ T _____ R _____	_____
4. Lot No. _____, Recorded Plat _____		
5. Private Claims _____		

Register of Deeds Stamp & File Number

1	A	B	C	D	E	F	G	H	I	J	K	L	M
2		5		5		●		3		2		1	
3						●							
4		7		8		9		10		11		12	
5													
6		16		17		16		15		14		13	
7													
8		19		20		21		22		23		24	
9													
10		30		29		28		27		26		25	
11													
12		31		32		33		34		35		36	
13													

I, Stephan J. Szyszkoski, in a field survey on F2 09/27/2011 do hereby state that under requirements of P.A. 74, Michigan P.A. of 1970, the corner points mentioned in lines 1 and 2 above were in conformance with regulations and rules therefore as required in the current manual of survey instructions of the United States Department of the Interior, Bureau of Land Management or by a decree of a Court of Law and /or that the corner points mentioned in lines 3, 4 and 5 above were in conformance with the rules of the Michigan Board of Land Surveyors or by a Decree of a Court of Law; established, re-established, monumented, recovered, found as expressed below:

NOTE: Not more than 2 corners, all in the same town and range, may be recorded on this certificate.

A. Description of original monument and accessories and/or subsequent restoration:

(F2) Center of Section 4. Not previously monumented.

(13-Sec. 4) Southeast 1/16 corner, Section 4. Not previously monumented.

B. Description of corner evidence found and/or method applied in restoring or reestablishing corner:

(F2) Established the position for the corner at the intersection of straight lines connecting opposite 1/4 corners.

(13-Sec. 4) Established the position for the corner at the intersection of straight lines connecting opposite 1/16 corners.


C. Description of monument for corner and accessories established to perpetuate locating the position of the corner:

(F2) Set 1"IDx32" I.pipe with 4" alum. MDNR cap. Set measuring nail with MDNR tag in the side of:
 8" Cedar N62E 33.8' mrkd "1/4C BT"
 12" Sugar S40E 16.4' do
 7" Sugar S66W 20.6' do
 10" Sugar N14W 20.35' do
 Set sq'd Cedar post adjacent.
 Bearings are magnetic.

(13) Set 1"IDx32" I.pipe with 4" alum. MDNR cap. Set measuring nail with MDNR tag in the side of:
 14" Sugar N26E 10.8' mrkd "1/16S BT"
 9" Sugar S30E 12.6' do
 10" Sugar S81W 23.6' do
 12" Sugar N71W 17.5' do
 Set sq'd Cedar post adjacent.
 Bearings are magnetic.

Signed by Stephan J. Szyszkoski
 Surveyor's Michigan License No. 33986

Date 01/19/2012

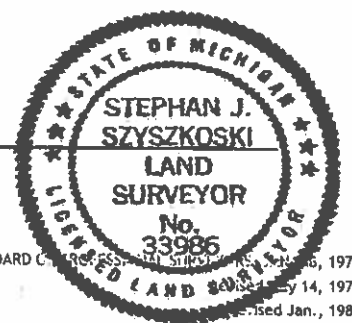

For the Michigan Department of Natural Resources, Forest Management Division

16803
16804