

**LAND CORNER RECORDATION CERTIFICATE**  
**Filing Requirement of Act 74, Mich. P.A. 1970 as Amended**

For corners in

Iron (County)	Located In:	Corner Code #
1. Public Land Survey	T _____ R _____	_____
	T _____ R _____	_____
	T _____ R _____	_____
2. Property Controlling in Section	S 4 T 44N R 31W	3
	S 4 T 44N R 31W	14
	S _____ T _____ R _____	_____
3. Miscellaneous Property in Sec.	S _____ T _____ R _____	_____
	S _____ T _____ R _____	_____
4. Lot No. _____, Recorded Plat _____		
5. Private Claims _____		

Register of Deeds Stamp & File Number

	A	B	C	D	E	F	G	H	I	J	K	L	M
1													
2	6			5	•	4		3		2		1	
3							•						
4	7			8		9		10		11		12	
5													
6	18			17		16		15		14		13	
7													
8	19			20		21		22		23		24	
9													
10	30			29		28		27		26		25	
11													
12	31			32		33		34		35		36	
13													

I, Stephan J. Szyszkoski, in a field survey on 3 09/22/2011 do hereby state that under requirements of P.A. 74, Michigan P.A. of 1970, the corner points mentioned in lines 1 and 2 above were in conformance with regulations and rules therefore as required in the current manual of survey instructions of the United States Department of the Interior, Bureau of Land Management or by a decree of a Court of Law and /or that the corner points mentioned in lines 3, 4 and 5 above were in conformance with the rules of the Michigan Board of Land Surveyors or by a Decree of a Court of Law; established, re-established, monumented, recovered, found as expressed below:

NOTE: Not more than 2 corners, all in the same town and range, may be recorded on this certificate.

**A. Description of original monument and accessories and/or subsequent restoration:**  
 (3-Sec. 4) North 1/16 corner between Sections 4 and 5. 1970 - Monumented by A.O. Enger RLS on line between 1/4 corner 20.025 ch. south and Section corner 18.925 ch. north. Set 3"x3"x6.5' squared cedar post, scribed. Sugar Maple 4" N39.5E 6.0', Sugar Maple 3" N21W 5.3'. The original plat of this township shows this corner being 20.00 ch. north of the 1/4 cor. and 18.90 ch. south of the Section corner.

(14-Sec. 4) South 1/16 corner between Sections 3 and 4. Not previously monumented.

**B. Description of corner evidence found and/or method applied in restoring or reestablishing corner:**  
 (3-Sec. 4) Established the position for the corner on the Section line between Quarter corner 1320.49' south and Section corner 1247.86' north, being proportionate to the dimensions given on the original plat. I found a post hole - the only remaining evidence of the 1970 monument - adjacent, approx. 0.5' south.


(14-Sec. 4) Established the position for the corner midway and on the Section line between Section corner 1322.41' south and Quarter corner 1322.41' north.

**C. Description of monument for corner and accessories established to perpetuate locating the position of the corner:**

(3) Set 1"IDx32" I.pipe with 4" alum. MDNR cap. Set measuring nail with MDNR tag in the side of: W'ly of 8" twin Sugar N28E 9.05' mrkd "1/16S BT" 8" Sugar S12E 21.05' do 7" R.Pine S74W 38.5' do 9" Sugar N16W 5.0' do Set sq'd cedar post adjacent. Bearings are magnetic.	(14) Set 1"IDx32" I.pipe with 4" alum. MDNR cap. Set measuring nail with MDNR tag in the side of: 6" Sugar N41E 35.8' mrkd "1/16S BT" 18" Maple S68E 10.05' do 15" Maple S59W 11.25' do 8" Maple N61W 19.2' do Set sq'd cedar post adjacent. Bearings are magnetic.
---	--

Signed by Stephan J. Szyszkoski Date 01/19/2012  
 Surveyor's Michigan License No. 33986

For the Michigan Department of Natural Resources, Forest Management Division

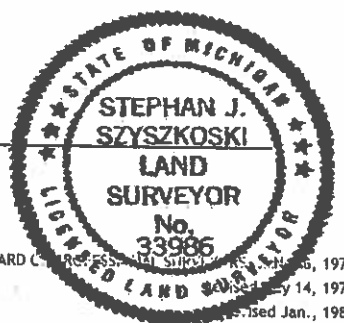

16799  
16800