

LAND CORNER RECORDATION CERTIFICATE
Filing Requirement of Act 74, Mich. P.A. 1970

For corners in

Iron	Located In:	Corner Code #
<small>(County)</small>		
1. Public Land Survey	T <u>44N</u> R <u>31W</u>	<u>H1</u>
	T _____ R _____	_____
	T _____ R _____	_____
	T _____ R _____	_____
2. Property Controlling in Section	S <u>3</u> T <u>44N</u> R <u>31W</u>	<u>2</u>
	S _____ T _____ R _____	_____
3. Miscellaneous Property in Sec.	S _____ T _____ R _____	_____
	S _____ T _____ R _____	_____

Register of Deeds Stamp & File Number

4. Lot No. _____, Recorded Plat _____
 5. Private Claims _____

Aug 29 2002

I, Stephan J. Szyszkoski, in a field survey on _____, 20____ do hereby state that under requirements of P.A. 74, Michigan P.A. of 1970, the corner points mentioned in lines 1 and 2 above were in conformance with regulations and rules therefore as required in the current manual of survey instructions of the United States Department of the Interior, Bureau of Land Management or by a decree of a Court of Law and/or that the corner points mentioned in lines 3, 4 and 5 above were in conformance with the rules of the Michigan Board of Land Surveyors or by a Decree of a Court of Law; established, re-established, monumented, recovered, found as expressed below:

NOTE: Not more than 2 corners, all in the same town and range, may be recorded on this certificate.

	A	B	C	D	E	F	G	H	I	J	K	L	M
1													
2		6		5		4		3		2		1	
3													
4		7		8		9		10		11		12	
5													
6		10		17		16		15		14		13	
7													
8		19		20		21		22		23		24	
9													
10		30		29		28		27		26		25	
11													
12		31		32		33		34		35		36	
13													

A. Description of original monument and accessories and/or subsequent restoration:

(H1) Quarter corner common to Section 3, T44N-R31W and Section 34, T45N-R31W. 1968: Monumented by A.O.Enger, RLS: "Corner reestablished by proportionate measurement between Section Corners 40.23 chains to East and West. Found no visible evidence of the original corner monument or its accessories or of any replacement monument or accessories...". Mr. Enger chiseled a "+" at the corner position and set a reference monument, a 1" pipe with 4" alum. cap, 2.00 links south.

(2-Sec.3) East 1/16 corner between Section 3, T44N-R31W and Section 34, T45N-R31W. 1968: Monumented by A.O.Enger, RLS: "Corner established midway on line between Section Corner 20.11 chains East and 1/4 corner 20.11 chains West...".

B. Description of corner evidence found and/or method applied in restoring or reestablishing corner:


(H1) Recovered the 1968 chiseled "+" 15.96' west of the position intended in 1968. Did not accept the 1968 position and reestablished the corner midway and on a line of mean true bearing between Section Corners 2650.89' East and West. Removed the reference monument noted in Mr. Enger's record.

(2-Sec. 3) Recovered the 1968 monument and accessories 18.58' west of the position intended in 1968. Did not accept the 1968 position and reestablished the corner midway and on a line of mean true bearing between Section Corner 1325.44' East and 1/4 corner 1325.44' West. Removed the 1968 monument.

C. Description of monument for corner and accessories established to perpetuate locating the position of the corner:

(H1) Set 1" IDx32" I.pipe with 4" alum. MDNR cap. Blazed and scribed:
 8" Sugar N04W 10.2' "1/4S NBT"
 *11" Sugar N56E 16.2' old blaze
 11" Sugar S40W 23.0' "1/4S NBT"
 *15" Sugar S77W 32.6' old blaze
 Bearings are magnetic. Distances are to notch in lower blaze. * denotes re-measured 1968 accessory.

(2) Set 1" IDx32" I.pipe with 4" alum. MDNR cap. Blazed and scribed:
 5" Sugar N87E 27.5' "1/16S BT"
 9" Sugar S27E 6.0' do
 10" Maple N75W 14.7' do
 8" Maple N18W 3.3' do
 Bearings are magnetic. Distances are to notch in lower blaze.

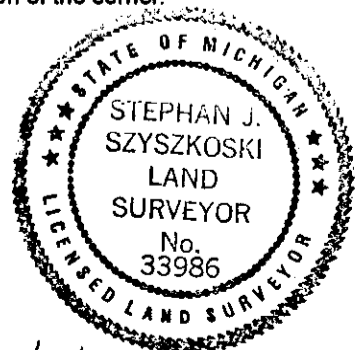

Signed by Stephan J. Szyszkoski
 Surveyor's Michigan License No. 33986

Date 9/9/02