LAND CORNER RECORDATION CERTIFICATE

Filing Requirement of Act 74, Mich. P.A. 1970 as Amended

For corners in

Iron (County) Located In: Corner Code #

1. Public Land Survey T ____ R ____ ____
   T ____ R ____ ____
   T ____ R ____ ____
2. Property Controlling in Section S 19 T 44N R 31W ____ 6
   S ____ T ____ R ____ ____
   S ____ T ____ R ____ ____
3. Miscellaneous Property in Sec. S ____ T ____ R ____ ____
   S ____ T ____ R ____ ____
4. Lot No. ____, Recorded Plat ____
5. Private Claims

Register of Deeds Stamp & File Number

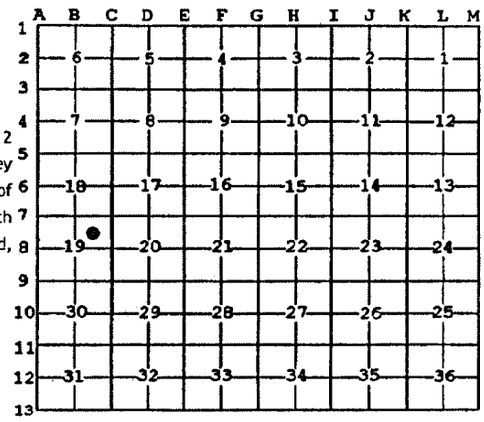

I, Stephan J. Szyszkoski, in a field survey on 06/02/2008 do hereby state that under requirements of P.A. 74, Michigan P.A. of 1970, the corner points mentioned in lines 1 and 2 above were in conformance with regulations and rules therefore as required in the current manual of survey instructions of the United States Department of the Interior, Bureau of Land Management or by a decree of a Court of Law and /or that the corner points mentioned in lines 3, 4 and 5 above were in conformance with the rules of the Michigan Board of Land Surveyors or by a Decree of a Court of Law; established, re-established, monumented, recovered, found as expressed below:

NOTE: Not more than 2 corners, all in the same town and range, may be recorded on this certificate.

A. Description of original monument and accessories and/or subsequent restoration:

Northeast 1/16 corner, Section 19. Not established in the original survey.

B. Description of corner evidence found and/or method applied in restoring or reestablishing corner:

Established the corner at the intersection of straight lines connecting opposite 1/16 corners. The position for the corner is in a flooding and is not accessible. Established two Witness Corners on the east, N-S 1/16 line, 575.07' north and 674.51' north of the 1/16 corner position, on dry ground.

C. Description of monument for corner and accessories established to perpetuate locating the position of the corner:

Southerly Witness Corner. Set 1"IDx32" I.pipe with 4" alum. MDNR cap 575.07' north of the corner position. Set measuring nail with MDNR tag in the side of:

17" W.Pine N30W 16.75'	mrkd "WC BT"
18" W.Pine N45E 27.95'	do
5" Spruce S41W 34.6'	do
16" W.Pine N77W 39.6'	do

Set sq'd post adjacent. Bearings magnetic.

Northerly Witness Corner. Set 1"IDx32" I.pipe with 4" alum. MDNR cap 674.51' north of the corner position. Set measuring nail with MDNR tag in the side of:

5" W.Pine N13E 26.2'	mrkd "WC BT"
10" W.Pine S70E 10.65'	do
18" W.Pine S12W 22.0'	do
5" Spruce N85W 28.4'	do

Set sq'd post adjacent. Bearings magnetic.

Signed by Stephan J. Szyszkoski Date 06/19/2008

Surveyor's Michigan License No. 33986

STATE OF MICHIGAN STEPHAN J. SZYSZKOSKI LAND SURVEYOR No. 33986 LICENSED LAND SURVEYOR

For the Michigan Department of Natural Resources, Office of Land and Facilities

16071

16072

FORM APPROVED BY MICHIGAN STATE BOARD OF PROFESSIONAL SURVEYORS, Nov. 6, 1971
Revised May 14, 1975
Revised Jan., 1983
Revised Oct., 1995