

**SURVEY & REMONUMENTATION**

**JAN 13 1998**

**SECTION**

**LAND CORNER RECORDATION CERTIFICATE**  
**Filing Requirement of Act 74, Mich. P.A. 1970**

IRON COUNTY  
 MICHIGAN  
 RECEIVED FOR RECORD

97 DEC 23 PM 1:28  
 L.C. Records 4.7 P. 138

*Gary L. Pisoni*  
 REGISTER OF DEEDS

For corners in

_____ Iron _____ (County)	Located In:	Corner Code #
1. Public Land Survey	T 44N R 32W	<u>A-4</u>
	T 44N R 33W	M-4
	T _____ R _____	_____
	T _____ R _____	_____
2. Property Controlling in Section	S _____ T _____ R _____	_____
	S _____ T _____ R _____	_____
3. Miscellaneous Property in Sec.	S _____ T _____ R _____	_____
	S _____ T _____ R _____	_____

Register of Deeds Stamp & File Number

4. Lot No. \_\_\_\_\_, Recorded Plat \_\_\_\_\_  
 5. Private Claims \_\_\_\_\_

Quarter Corner Section 7, T44N, R32W  
 Quarter Corner Section 12, T44N, R33W

I, Gary L. Pisoni, in a field survey on November 12, 1997 do hereby state that under requirements of P.A. 74, Michigan P.A. of 1970, the corner points mentioned in lines 1 and 2 above were in conformance with regulations and rules therefore as required in the current manual of survey instructions of the United States Department of the Interior, Bureau of Land Management or by a decree of a Court of Law and /or that the corner points mentioned in lines 3, 4 and 5 above were in conformance with the rules of the Michigan Board of Land Surveyors or by a Decree of a Court of Law; established, re-established, monumented, recovered, found as expressed below:

	A	B	C	D	E	F	G	H	I	J	K	L	M
1													
2	6		5		4		3		2		1		
3													
4	7		8		9		10		11		12		
5													
6	18		17		16		15		14		13		
7													
8	19		20		21		22		23		24		
9													
10	30		29		28		27		26		25		
11													
12	31		32		33		34		35		36		
13													

NOTE: Not more than 2 corners, all in the same town and range, may be recorded on this certificate.

PEER GROUP APPROVED  
*Gary L. Pisoni 12-1-97*  
 IRON COUNTY REPRESENTATIVE

A. Description of original monument and accessories and/or subsequent restoration:

Original Corner established in 1846 by Austin Burt, U.S. Deputy Surveyor.  
 Original Corner: Spruce Post  
 Original Bearing Trees: Tamarack 6" S70°E 25 lks.(16.50 feet)  
 Tamarack 7" N82°W 40 lks.(26.40 feet)


B. Description of corner evidence found and/or method applied in restoring or reestablishing corner:

No original or subsequent corner evidence was recovered. I restored the corner position by single proportionate measurement on line between the Northwest and Southwest Section Corners of Section 7.  
 Corner record research on file with County Representative.

C. Description of monument for corner and accessories established to perpetuate locating the position of the corner:

At the corner position, set a 3/4 inch outside diameter aluminum rod monument, 4 feet long, flush with the ground, with a 3 inch diameter aluminum cap stamped as follows: Iron County Remonumentation, T44N, R32W, R33W, 1/4, S12, S7, 1997, RLS 27457. Blazed and scribed the following new bearing trees: (Measurements are taken to a nail in side of tree)

Black Spruce	10"	N08°E	16.74 feet
Cedar	9"	S70°E	20.66 feet
Black Spruce	7"	S11°E	33.00 feet
Black Spruce	8"	S56°W	16.20 feet
Steel Sign Post		N80°W	0.69 feet

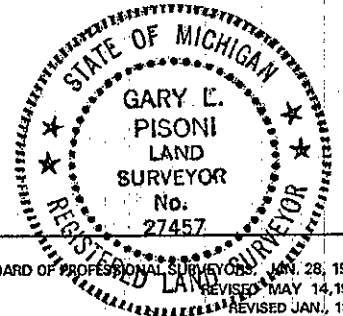

97-33  
 Signed by Gary L. Pisoni  
 Surveyor's Michigan License No. 27457

Date November 29, 1997