

**SURVEY & REMONUMENTATION**

**JAN 13 1998**

**SECTION**

IRON COUNTY  
MICHIGAN  
RECEIVED FOR RECORD

97 DEC 23 PM 1:28  
L.C. Records 6:7 P. 140

**LAND CORNER RECORDATION CERTIFICATE**  
Filing Requirement of Act 74, Mich. P.A. 1970

*Richard L. Pisoni*  
REGISTER OF DEEDS

For corners in

_____ Iron _____ (County)	Located In:	Corner Code #
1. Public Land Survey	T 44N R 32W	<u>A-6</u>
	T 44N R 33W	M-6
	T _____ R _____	_____
	T _____ R _____	_____
2. Property Controlling in Section	S _____ T _____ R _____	_____
	S _____ T _____ R _____	_____
3. Miscellaneous Property in Sec.	S _____ T _____ R _____	_____
	S _____ T _____ R _____	_____

Register of Deeds Stamp & File Number

4. Lot No. \_\_\_\_\_, Recorded Plat \_\_\_\_\_  
5. Private Claims \_\_\_\_\_

Quarter Corner Section 18, T44N, R32W  
Quarter Corner Section 13, T44N, R33W

I, Gary L. Pisoni, in a field survey on November 12, 1997 do hereby state that under requirements of P.A. 74, Michigan P.A. of 1970, the corner points mentioned in lines 1 and 2 above were in conformance with regulations and rules therefore as required in the current manual of survey instructions of the United States Department of the Interior, Bureau of Land Management or by a decree of a Court of Law and /or that the corner points mentioned in lines 3, 4 and 5 above were in conformance with the rules of the Michigan Board of Land Surveyors or by a Decree of a Court of Law; established, re-established, monumented, recovered, found as expressed below:

	A	B	C	D	E	F	G	H	I	J	K	L	M
1													
2		6		5		4		3		2		1	
3													
4		7		8		9		10		11		12	
5													
6		13		17		16		15		14		13	
7													
8		19		20		21		22		23		24	
9													
10		30		29		28		27		26		25	
11													
12		31		32		33		34		35		36	
13													

NOTE: Not more than 2 corners, all in the same town and range, may be recorded on this certificate.

PEER GROUP APPROVED

*Gary L. Pisoni 12-1-97*  
IRON COUNTY REPRESENTATIVE

A. Description of original monument and accessories and/or subsequent restoration:

Original corner established in 1846 by Austin Burt, U.S. Deputy Surveyor.  
Original Corner: Sugar Post  
Original Bearing Trees: Lynn 6" S69°W 22 lks.(14.52 feet)  
Sugar 10" N75°E 45 lks.(29.70 feet)


B. Description of corner evidence found and/or method applied in restoring or reestablishing corner:

No original corner evidence was recovered.  
Found a 6 inch diameter squared post and a 1 1/4 inch diameter iron pipe marking the corner position. I accept the wood post and iron pipe as the best available evidence for restoring the corner position.  
Corner record research on file with County Representative.

C. Description of monument for corner and accessories established to perpetuate locating the position of the corner:

In place of wood post and iron pipe, set a 2 inch diameter aluminum monument, 3 feet long, 2 inches above the ground surface, with an aluminum cap stamped; Iron County Remonumentation, T44N, R32W, R33W, 1/4, S13, S18, 1997, RLS 27457. Blazed and scribed the following new bearing trees:(Measurements are taken to a nail in side of tree)

Sugar	6"	S67°W	40.02 feet
Sugar	6"	N73°W	36.88 feet
DBL Sugar	7"	N12°E	76.58 feet
Sugar	12"	S38°E	28.55 feet
Steel Sign Post		North	1.10 feet

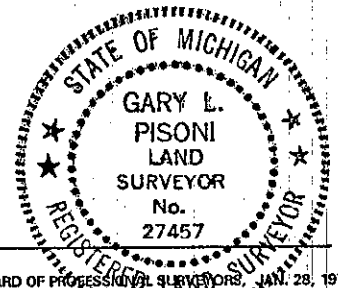

97-35  
Signed by Gary L. Pisoni  
Surveyor's Michigan License No. 27457

Date November 29, 1997