

LAND CORNER RECORDATION CERTIFICATE
Filing Requirement of Act 74, Mich. P.A. 1970

For corners in

Iron	Located In:	Corner Code #
(County)		
1. Public Land Survey	T ___ R ___	_____
	T ___ R ___	_____
	T ___ R ___	_____
	T ___ R ___	_____
2. Property Controlling in Section	S <u>10</u> T <u>44N</u> R <u>32W</u>	<u>11</u>
	S <u>10</u> T <u>44N</u> R <u>32W</u>	<u>10</u>
3. Miscellaneous Property in Sec.	S ___ T ___ R ___	_____
	S ___ T ___ R ___	_____

Register of Deeds Stamp & File Number

4. Lot No. _____, Recorded Plat _____
 5. Private Claims _____

May 08 2002

I, Stephan J. Szyszkoski, in a field survey on _____, 20__ do hereby state that under requirements of P.A. 74, Michigan P.A. of 1970, the corner points mentioned in lines 1 and 2 above were in conformance with regulations and rules therefore as required in the current manual of survey instructions of the United States Department of the Interior, Bureau of Land Management or by a decree of a Court of Law and /or that the corner points mentioned in lines 3, 4 and 5 above were in conformance with the rules of the Michigan Board of Land Surveyors or by a Decree of a Court of Law; established, re-established, monumented, recovered, found as expressed below:

NOTE: Not more than 2 corners, all in the same town and range, may be recorded on this certificate.


A	B	C	D	E	F	G	H	I	J	K	L	M
1												
2	6	5	4	3	2	1						
3												
4	7	8	9	10	11	12						
5												
6	18	17	16	15	14	13						
7												
8	19	20	21	22	23	24						
9												
10	30	29	28	27	26	25						
11												
12	31	32	33	34	35	36						
13												

A. Description of original monument and accessories and/or subsequent restoration:
 (11-Sec. 10) Southwest 1/16 corner, Section 10. Not established in the original survey.
 (10-Sec. 10) South 1/16 corner between Sections 9 & 10. Not established in the original survey.

B. Description of corner evidence found and/or method applied in restoring or reestablishing corner:
 (11-Sec. 10) Established the corner at the intersection of straight lines connecting opposite 1/16 corners (1/16 corners to east and south are unmonumented).
 (10-Sec. 10) Established the corner midway and on a line of mean true bearing between Section corner 1319.95' south and Quarter corner 1319.95' north. From the corner thus established, I found a 2" ID iron pipe, projecting 3.9', set firmly, not of record, set by unknown persons, S48E 6.7' distant, which I did not accept as marking the position of the corner.

C. Description of monument for corner and accessories established to perpetuate locating the position of the corner:

(11) Set 1"IDx32" I.pipe with 4" alum. MDNR cap. Blazed and scribed: 27" W.Pine N32E 33.8' "1/16S BT" 19" W.Pine N70E 22.2' do 4" Spruce S48W 9.9' do 6" Spruce N42W 20.9' do Set squared tam. post adjacent. Bearings are magnetic. Distances are to notch in lower blaze.	(10) Set 1"IDx32" I.pipe with 4" alum. MDNR cap. Blazed and scribed: 16" Sugar N48E 35.2' "1/16S BT" 7" Sugar S10E 16.4' do 11" Sugar N81W 11.7' do 14" Sugar N09W 20.8' do Set squared tam. post adjacent. Bearings are magnetic. Distances to notch in lower blaze.
---	---

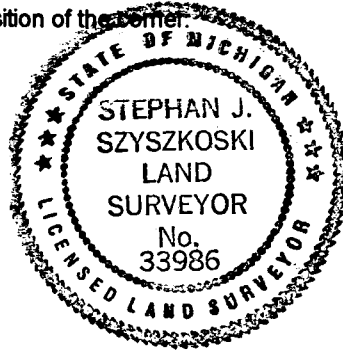

Signed by Stephan J. Szyszkoski
 Surveyor's Michigan License No. 33986

Date 6/10/02