

LAND CORNER RECORDATION CERTIFICATE
Filing Requirement of Act 74, Mich. P.A. 1970 as Amended

For corners in

| | | |
|------------------------------------|-------------------|---------------|
| <u>Iron</u> (County) | Located In: | Corner Code # |
| 1. Public Land Survey | T ___ R ___ | _____ |
| | T ___ R ___ | _____ |
| | T ___ R ___ | _____ |
| 2. Property Controlling in Section | S ___ T ___ R ___ | _____ |
| | S 33 T 44N R 32W | 16 |
| | S 33 T 44N R 32W | 10 |
| 3. Miscellaneous Property in Sec. | S ___ T ___ R ___ | _____ |
| | S ___ T ___ R ___ | _____ |

Register of Deeds Stamp & File Number

4. Lot No. _____, Recorded Plat _____
 5. Private Claims _____

Jan 12 2005

I, Stephan J. Szyszkoski, in a field survey on _____, 20____ do hereby state that under requirements of P.A. 74, Michigan P.A. of 1970, the corner points mentioned in lines 1 and 2 above were in conformance with regulations and rules therefore as required in the current manual of survey instructions of the United States Department of the Interior, Bureau of Land Management or by a decree of a Court of Law and /or that the corner points mentioned in lines 3, 4 and 5 above were in conformance with the rules of the Michigan Board of Land Surveyors or by a Decree of a Court of Law; established, re-established, monumented, recovered, found as expressed below:

| | | | | | | | | | | | | | |
|----|---|----|---|----|---|----|---|----|---|----|---|----|---|
| 1 | A | B | C | D | E | F | G | H | I | J | K | L | M |
| 2 | | 6 | 5 | | 4 | | 3 | | 2 | | 1 | | |
| 3 | | | | | | | | | | | | | |
| 4 | | 7 | | 8 | | 9 | | 10 | | 11 | | 12 | |
| 5 | | | | | | | | | | | | | |
| 6 | | 18 | | 17 | | 16 | | 15 | | 14 | | 13 | |
| 7 | | | | | | | | | | | | | |
| 8 | | 19 | | 20 | | 21 | | 22 | | 23 | | 24 | |
| 9 | | | | | | | | | | | | | |
| 10 | | 30 | | 29 | | 28 | | 27 | | 26 | | 25 | |
| 11 | | | | | | | | | | | | | |
| 12 | | 31 | | 32 | | 33 | | 34 | | 35 | | 36 | |
| 13 | | | | | | | | | | | | | |

NOTE: Not more than 2 corners, all in the same town and range, may be recorded on this certificate.

A. Description of original monument and accessories and/or subsequent restoration:


(16-Sec. 33) East 1/16 corner between Section 33, T44N-R32W and Section 4 T43N-R32W. Not established in the original survey.
 (10-Sec. 33) South 1/16 corner between Sections 32-33. Previously monumented in 1984 by K.L. Sackett, RLS 19006: Established on line between corners north and south. Set 1"IDx64" IP with 4" aluminum cap. 7" Cedar N70W 52.1', 12" Tam. N30E 87.5'.

B. Description of corner evidence found and/or method applied in restoring or reestablishing corner:

(16-Sec. 33) Found the corner recently monumented with a 5/8" dia. rebar, projecting 2.5" above ground, set by Gary L. Pisoni PS 27457. The monument is midway and on line between Quarter and Section corners. Accepted same as a careful and faithful determination of the position of the corner.
 (10-Sec. 33) Recovered the 1984 monument in good condition, and at record bearing and distance from the 1984 witnesses. Determined that the 1984 monument was installed in an erroneous position, about 4.0' south of the position intended. Destroyed the 1984 monument and reestablished the corner position midway and on line between Section corner 1320.32' south and a calculated position for Quarter corner 1320.32' north. The 1/4 corner position is as determined by Gary L. Pisoni, PS 27457, being the intersection of the E-W 1/4 line (by mean bearings) with a straight line between Section corners E11 and E13.

C. Description of monument for corner and accessories established to perpetuate locating the position of the corner:

| | |
|--|--|
| (16) Found 5/8" dia. rebar. Set measuring nails in: | (10) Set 1"IDx32" I.pipe with 4" alum. MDNR cap. Set measuring nails in: |
| 14" Sugar S71E 77.1' mrkd "1/16S BT" | 18" W.Pine N24E 111.7' mrkd "1/16S 8T" |
| 16" W.Spruce S38W 55.4' do | 12" Cedar N71W 51.5' 1984 witness |
| 5" Apple in clump N65W 5.9' do | 20" Tamarack N45W 27.1' mrkd "1/16S BT" |
| 8" twin Cherry N30W 22.9' do | 8" W.Pine North 84.5' do |
| Bearings are magnetic. Distances are to nail with tag. | Bearings are magnetic. Distances are to nail with tag. |

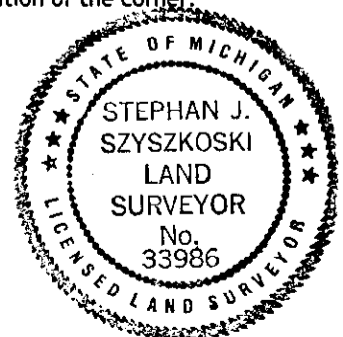

Signed by Stephan J. Szyszkoski
 Surveyor's Michigan License No. 33986

Date 1/18/05