LAND CORNER RECORDATION CERTIFICATE
Filing Requirement of Act 74, Mich. P.A. 1970 as Amended

For corners in

Iron (County)

		Located In:	Corner Code #
1. Public Land Survey		T 44N R 32W	H12
		T___ R___	
		T___ R___	
	S___	T___ R___	
2. Property Controlling	S 33	T 44N R 32W	6
in Section	S___	T___ R___	
3. Miscellaneous	S___	T___ R___	
Property in Sec.	S___	T___ R___	

Register of Deeds Stamp & File Number

4. Lot No. _____ , Recorded Plat_____

5. Private Claims

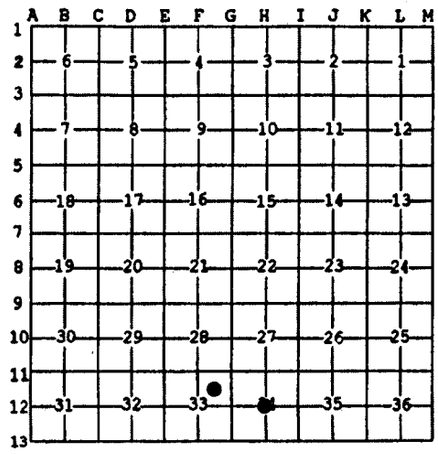

Oct 25 2006

I, Stephan J. Szyszkoski, in a field survey on _____, 20 ____ do hereby state that under requirements of P.A. 74, Michigan P.A. of 1970, the corner points mentioned in lines 1 and 2 above were in conformance with regulations and rules therefore as required in the current manual of survey instructions of the United States Department of the Interior, Bureau of Land Management or by a decree of a Court of Law and /or that the corner points mentioned in lines 3, 4 and 5 above were in conformance with the rules of the Michigan Board of Land Surveyors or by a Decree of a Court of Law; established, re-established, monumented, recovered, found as expressed below:

NOTE: Not more than 2 corners, all in the same town and range, may be recorded on this certificate.

A. Description of original monument and accessories and/or subsequent restoration:

(H12) Center of Section 34. Not established in the original survey. Found no subsequent record.
(6-Sec. 33) Northeast 1/16 corner, Section 33. 2005 - Established and recorded by the undersigned.

B. Description of corner evidence found and/or method applied in restoring or reestablishing corner:

(H12) Established the corner at the intersection of straight lines connecting opposite 1/4 corners. From the position thus established, I found a 1" dia. iron pin, not of record, N45W 25.6' distant, which I did not accept as marking the position for the corner.
(6-Sec. 33) Determined that the 2005 position for the corner is erroneous by virtue of the remonumentation of corners G11 and G12 by Gary L. Pisoni PS in 2005, and the subsequent remonumentation of 1/16 corners #2 and #7 of Section 33 by the undersigned. Removed the 2005 monument and reestablished the corner at the intersection of straight lines connecting opposite 1/16 corners. The 2005 position was found to be 12.2' west of the reestablished position.

C. Description of monument for corner and accessories established to perpetuate locating the position of the corner:

(H12) Set 1"IDx32" I.pipe with 4" alum. MDNR cap. Set measuring nails in:
14" Sugar N05W 34.9' mrkd "C1/4 BT"
8" Y.Birch S43E 19.8' do
8" Sugar S33W 20.2' do
8" Sugar N20W 30.0' do
Set sq'd cedar post adjacent. Bearings are magnetic. Distances are to nail with tag.

(6) Set 1"IDx32" I.pipe with 4" alum. MDNR cap. Set measuring nails in:
6" Maple S23E 31.3' mrkd "1/16S BT"
15" Oak in clump N54E 23.2' do
6" Maple S04E 55.55' do
10" Maple in clump S66W 42.7' do
Sq'd cedar post adjacent. Bearings are magnetic. Distances are to nail with tag.

STATE OF MICHIGAN
STEPHAN J. SZYSZKOSKI
LAND SURVEYOR
No. 33986
LICENSED LAND SURVEYOR

Signed by Stephan J. Szyszkoski Date 10/31/06

Surveyor's Michigan License No. 33986

For the Michigan Department of Natural Resources, Office of Land and Facilities

FORM APPROVED BY MICHIGAN STATE BOARD OF PROFESSIONAL SURVEYORS, JAN. 28, 1971
Revised May 14, 1975
Revised Jan., 1983
Revised Oct., 1995