LAND CORNER RECORDATION CERTIFICATE
Filing Requirement of Act 74, Mich. P.A. 1970 as Amended

For corners in

Iron (County)

	Located In:			Corner Code #
1. Public Land Survey		T___	R___	
		T___	R___	
		T___	R___	
	S___	T___	R___	
2. Property Controlling	S 33	T 44N	R 32W	7
in Section	S 33	T 44N	R 32W	2
3. Miscellaneous	S___	T___	R___	
Property in Sec.	S___	T___	R___	

Register of Deeds Stamp & File Number

4. Lot No. _____ , Recorded Plat_____

5. Private Claims

2 Oct 25 2006
7 Oct 24 2006

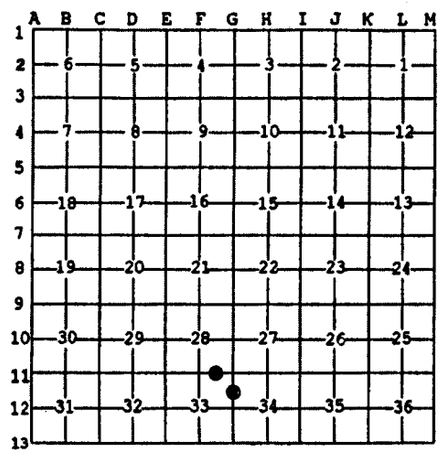

I, Stephan J. Szyszkoski, in a field survey on _____, 20 ____ do hereby state that under requirements of P.A. 74, Michigan P.A. of 1970, the corner points mentioned in lines 1 and 2 above were in conformance with regulations and rules therefore as required in the current manual of survey instructions of the United States Department of the Interior, Bureau of Land Management or by a decree of a Court of Law and /or that the corner points mentioned in lines 3, 4 and 5 above were in conformance with the rules of the Michigan Board of Land Surveyors or by a Decree of a Court of Law; established, re-established, monumented, recovered, found as expressed below:

NOTE: Not more than 2 corners, all in the same town and range, may be recorded on this certificate.

A. Description of original monument and accessories and/or subsequent restoration:

(7-Sec. 33) North 1/16 corner between Sections 33 and 34. 1984 - Established by K.L.Sackett RLS midway and on line between Section corner north and Quarter corner south. 2005 - the 1984 monument was recovered, rewitnessed, and recorded by the undersigned.
(2-Sec. 33) East 1/16 corner between Sections 28 and 33. 1984 - Established by K.L.Sackett RLS. 2005 - the 1984 monument was recovered, rewitnessed and recorded by the undersigned.

B. Description of corner evidence found and/or method applied in restoring or reestablishing corner:

(7-Sec. 34) Determined the 1984 position for the corner to be erroneous by virtue of the remonumentation of corners G11 and G12 by Gary L. Pisoni PS in 2005. Removed the 1984 monument and reestablished this 1/16 corner midway and on line between said corners G11 1321.25' north and G12 1321.25' south. The 1984 position was found to be 24' west of the reestablished position.
(2-Sec. 33)Determined the 1984 position for the corner to be erroneous by virtue of the remonumentation of Section corner G11 by Gary L. Pisoni PS in 2005. Removed the 1984 monument and reestablished this 1/16 corner midway and on the section line between Quarter corner F11 1323.68' west and Section corner 1323.68' east. The 1984 position was found to be 16.4' west of the reestablished position.

C. Description of monument for corner and accessories established to perpetuate locating the position of the corner:

(7) Set 1"IDx32" I.pipe with 4" alum. MDNR cap. Set measuring nails in:
7" Poplar N77W 13.0' mrkd "1/16S BT"
6" Maple in clump S06E 30.2' do
Poplar N69W 37.2' do
5" Poplar N73E 16.5' do
Set sq'd cedar post adjacent. Bearings are magnetic. Distances are to nail with tag.

(2) Set 1"IDx32" I.pipe with 4" alum. MDNR cap. Set measuring nails in:
5" Cherry N03E 40.0' mrkd "1/16S BT"
13" W.Pine S28W 147.8' do
3" W.Spruce S86W 71.0' do
11" Poplar S59W 35.6' old blazes
Sq'd cedar post adjacent. Bearings are magnetic. Distances are to nail with tag.

STATE OF MICHIGAN
STEPHAN J. SZYSZKOSKI
LAND SURVEYOR
No. 33986
LICENSED LAND SURVEYOR

Signed by Stephan J. Szyszkoski Date 10/31/06

Surveyor's Michigan License No. 33986

For the Michigan Department of Natural Resources, Office of Land and Facilities

FORM APPROVED BY MICHIGAN STATE BOARD OF PROFESSIONAL SURVEYORS, JAN. 28, 1971
Revised May 14, 1975
Revised Jan., 1983
Rervised Oct., 1995