LAND CORNER RECORDATION CERTIFICATE
Filing Requirement of Act 74, Mich. P.A. 1970 as Amended

For corners in

Iron (County)

	Located In:			Corner Code #
1. Public Land Survey		T____	R____	
		T____	R____	
		T____	R____	
	S____	T____	R____	
2. Property Controlling	S 34	T 44N	R 32W	7
in Section	S 34	T 44N	R 32W	5
3. Miscellaneous	S____	T____	R____	
Property in Sec.	S____	T____	R____	

Register of Deeds Stamp & File Number

4. Lot No. _____ , Recorded Plat_____
5. Private Claims

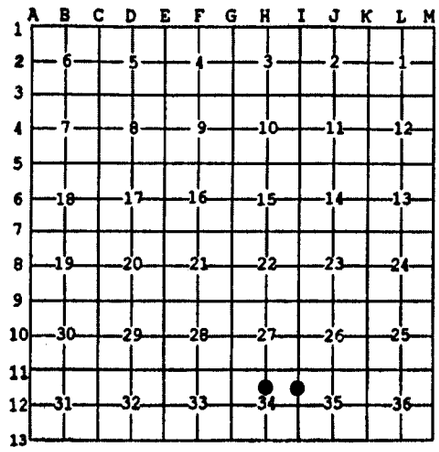

Oct 24 2006

I, Stephan J. Szyszkoski, in a field survey on _____, 20 ____ do hereby state that under requirements of P.A. 74, Michigan P.A. of 1970, the corner points mentioned in lines 1 and 2 above were in conformance with regulations and rules therefore as required in the current manual of survey instructions of the United States Department of the Interior, Bureau of Land Management or by a decree of a Court of Law and /or that the corner points mentioned in lines 3, 4 and 5 above were in conformance with the rules of the Michigan Board of Land Surveyors or by a Decree of a Court of Law; established, re-established, monumented, recovered, found as expressed below:

NOTE: Not more than 2 corners, all in the same town and range, may be recorded on this certificate.

A. Description of original monument and accessories and/or subsequent restoration:

(7-Sec. 34) North 1/16 corner between Sections 34 and 35. 1987 - Established by K.L.Sackett RLS midway and on line between Section and Quarter corner. Set 1"IDx32" I.pipe with 4" alum. cap. 18" Tamarack S15E 35.4', 20" Tamarack N89E 30.8', 5" Cherry S60W 18.7'.
(5-Sec. 34) North 1/16 corner Section 34. Not established in the original survey.

B. Description of corner evidence found and/or method applied in restoring or reestablishing corner:

(7-Sec. 34) Found and accepted the 1987 monument in good condition, at record bearing and distance from the 1987 witnesses. The Cherry BT is in good condition, the Tamarack S15E is a dead stub, and the Tamarack N89E has been windthrown. Left the monument in place and made new witnesses as described below.
(5-Sec. 34) Established the corner midway and on a straight line between Quarter corner 1324.04' north and Center of Section 1324.04' south. From the position thus established, I found a 1" pipe, loosely set, N80W 40.9' distant which I did not accept as marking the position of the corner.

C. Description of monument for corner and accessories established to perpetuate locating the position of the corner:

(7) Found 1"ID I.pipe with 4" alum. MDNR cap. Set measuring nails in:
8" Cherry S64W 18.9' old blazes *
20" Tamarack N50W 51.8' mrkd "S1/16 BT"
9" Cherry N06W 34.9' do
20" Tamarack S53E 42.9' do
Set sq'd cedar post adjacent. Bearings are magnetic. Distances are to nail with tag. * denotes 1987 BT.

(5) Set 1"IDx32" I.pipe with 4" alum. MDNR cap. Set measuring nails in:
4" B.Spruce S17W 35.2' mrkd "1/16S BT"
8" Maple in clump N27E 44.0' do
11" twin Maple N53E 45.4' do
4" Maple in clump N73W 17.5' do
Set sq'd cedar post adjacent. Bearings are magnetic. Distances are to nail with tag.

STATE OF MICHIGAN
STEPHAN J. SZYSZKOSKI
LAND SURVEYOR
No. 33986
LICENSED LAND SURVEYOR

Signed by Stephan J. Szyszkoski Date 10/31/06

Surveyor's Michigan License No. 33986

For the Michigan Department of Natural Resources, Office of Land and Facilities

FORM APPROVED BY MICHIGAN STATE BOARD OF PROFESSIONAL SURVEYORS, JAN. 28, 1971
Revised May 14, 1975
Revised Jan., 1983
Rervised Oct., 1995