LAND CORNER RECORDATION CERTIFICATE
Filing Requirement of Act 74, Mich. P.A. 1970 as Amended

For corners in

Iron
(County)

	Located In:			Corner Code #
1. Public Land Survey		T____	R____	
		T____	R____	
		T____	R____	
	S____	T____	R____	
2. Property Controlling	S 33	T 44N	R 32W	13
in Section	S____	T____	R____	
3. Miscellaneous	S____	T____	R____	
Property in Sec.	S____	T____	R____	

Register of Deeds Stamp & File Number

4. Lot No. _____ , Recorded Plat_____
5. Private Claims

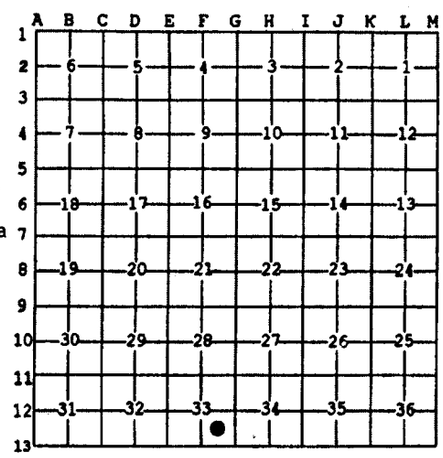

Oct 25 2006

I, Stephan J. Szyszkoski, in a field survey on _____, 20 ____ do hereby state that under requirements of P.A. 74, Michigan P.A. of 1970, the corner points mentioned in lines 1 and 2 above were in conformance with regulations and rules therefore as required in the current manual of survey instructions of the United States Department of the Interior, Bureau of Land Management or by a decree of a Court of Law and /or that the corner points mentioned in lines 3, 4 and 5 above were in conformance with the rules of the Michigan Board of Land Surveyors or by a Decree of a Court of Law; established, re-established, monumented, recovered, found as expressed below:

NOTE: Not more than 2 corners, all in the same town and range, may be recorded on this certificate.

A. Description of original monument and accessories and/or subsequent restoration:

(13-Sec. 33) Southeast 1/16 corner, Section 33. 2005 - Established and recorded by the undersigned.

B. Description of corner evidence found and/or method applied in restoring or reestablishing corner:

(13-Sec. 33) Determined that the 2005 position for the corner is erroneous by virtue of the remonumentation of Quarter corner G12 by Gary L Pisoni PS in 2005 and by the subsequent remonumentation of 1/16 corner #14 of Section 33 by the undersigned. Removed the 2005 monument and restablished the SE1/16 corner position at the intersection of straight lines connecting opposite 1/16 corners. The 2005 position was found to be 4.0' west of the reestablished position.

C. Description of monument for corner and accessories established to perpetuate locating the position of the corner:

(13) Set 1"IDx32" I.pipe with 4" alum.
MDNR cap. Set measuring nails in:
7" Spruce N57E 26.4' mrkd "1/16S BT"
12" W.Spruce S28E 31.0' do
14" W.Spruce N89W 19.6' do
12" W.Spruce N14W 38.1' do
Sq'd cedar post adjacent. Bearings are magnetic. Distances are to nail with tag.

STATE OF MICHIGAN
STEPHAN J. SZYSZKOSKI
LAND SURVEYOR
No. 33986
LICENSED LAND SURVEYOR

Signed by Stephan J. Szyszkoski Date 10/31/06

Surveyor's Michigan License No. 33986

For the Michigan Department of Natural Resources, Office of Land and Facilities

FORM APPROVED BY MICHIGAN STATE BOARD OF PROFESSIONAL SURVEYORS, JAN. 28, 1971
Revised May 14, 1975
Revised Jan., 1983
Rervised Oct., 1995