

LAND CORNER RECORDATION CERTIFICATE
Filing Requirement of Act 74, Mich. P.A. 1970 as Amended

For corners in

<u>Iron</u> (County)	Located In:	Corner Code #
1. Public Land Survey	T ___ R ___	_____
	T ___ R ___	_____
	T ___ R ___	_____
2. Property Controlling in Section	S <u>12</u> T <u>44N</u> R <u>32W</u>	<u>14</u>
	S <u>12</u> T <u>44N</u> R <u>32W</u>	<u>16</u>
3. Miscellaneous Property in Sec.	S ___ T ___ R ___	_____
	S ___ T ___ R ___	_____
4. Lot No. _____, Recorded Plat _____		
5. Private Claims		

Register of Deeds Stamp & File Number

	A	B	C	D	E	F	G	H	I	J	K	L	M
1													
2	6		5		4		3		2		1		
3													
4	7		8		9		10		11		12		
5													
6	18		17		16		15		14		13		
7													
8	19		20		21		22		23		24		
9													
10	30		29		28		27		26		25		
11													
12	31		32		33		34		35		36		
13													

I, Stephan J. Szyszkoski, in a field survey on Jan 17, 2008 do hereby state that under requirements of P.A. 74, Michigan P.A. of 1970, the corner points mentioned in lines 1 and 2 above were in conformance with regulations and rules therefore as required in the current manual of survey instructions of the United States Department of the Interior, Bureau of Land Management or by a decree of a Court of Law and /or that the corner points mentioned in lines 3, 4 and 5 above were in conformance with the rules of the Michigan Board of Land Surveyors or by a Decree of a Court of Law; established, re-established, monumented, recovered, found as expressed below:

NOTE: Not more than 2 corners, all in the same town and range, may be recorded on this certificate.

A. Description of original monument and accessories and/or subsequent restoration:

(14-Sec. 12) South 1/16 between Sec. 12 T44N-R32W and Sec. 7 T44N-R31W. 1989 - Established by K.L.Sackett RLS midway and on line between Section and 1/4 corners. Set 1"IDx32" I.pipe with 4" aluminum cap. 4" Balsam S06E 12.0', 8" Balsam N24E 12.3', 8" W.Birch N70W 18.3', 7" Balsam S40W 43.0', sq'd 7" W.Birch 6.3' north.

(16-Sec. 12) East 1/16 corner between Sections 12 and 13. 1989 - Established by K.L.Sackett RLS midway and on line between Section corner to east and computed position for 1/4 corner to west. Set 1"IDx32" I.pipe with 4" aluminum cap. 4" Tamarack N78W 77.3', 4" Tamarack N53W 82.7'.


B. Description of corner evidence found and/or method applied in restoring or reestablishing corner:

(14-Sec. 12) Recovered the 1989 monument in good condition, at the record position and in accord with the 1989 witnesses, only two of which - the Balsam SE and the Balsam SW - are alive. The W.Birch NW is a dead stub, the NE'ly Balsam is dead and down, the sq'd W.Birch was not recovered (possibly due to snow cover). Accepted the monument as a careful and faithful establishment of the position of the corner.

(16-Sec. 12) Recovered the 1989 monument in good condition, at the record position, and at record bearing and distance from the 1989 witness trees, now both dead. The corner falls in an open grassy marsh. Accepted the monument as a careful and faithful establishment of the position of the corner.

C. Description of monument for corner and accessories established to perpetuate locating the position of the corner:

(14) Fd. 1"ID I.pipe with 4" alum. MDNR cap. Set measuring nail with MDNR tag in the side of: 10" Balsam S07E 12.15' old blaze (1989 wit.) 10" Balsam S48W 43.4' do do 5" W.Spruce S67E 25.9' mrkd "1/16S BT" 7" Maple N06W 44.0' do	(16) Fd. 1"ID I.pipe with 4" alum. MDNR cap. Set measuring nail with MDNR tag in the side of: 12" Spruce N52W 162.45' mrkd "1/16S BT" 15" Spruce N42W 143.4' do 4" Spruce N28W 137.1' do 16" Spruce N14W 168.5' do
Bearings are magnetic. Set sq'd post adjacent.	Bearings are magnetic. Set sq'd post adjacent.

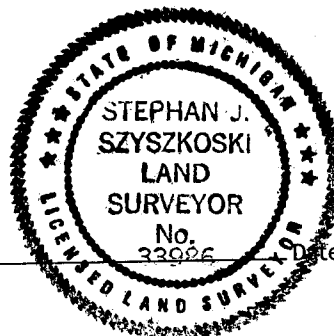

Signed by Stephan J. Szyszkoski

Surveyor's Michigan License No. 33986

Date 1/22/08