LAND CORNER RECORDATION CERTIFICATE
Filing Requirement of Act 74, Mich. P.A. 1970 as Amended

For corners in

Iron (County)

	Located In:			Corner Code #
1. Public Land Survey		T____	R____	
		T____	R____	
		T____	R____	
	S____	T____	R____	
2. Property Controlling	S 33	T 44N	R 32W	14
in Section	S 34	T 44N	R 32W	12
3. Miscellaneous	S____	T____	R____	
Property in Sec.	S____	T____	R____	

Register of Deeds Stamp & File Number

4. Lot No. _____ , Recorded Plat_____
5. Private Claims

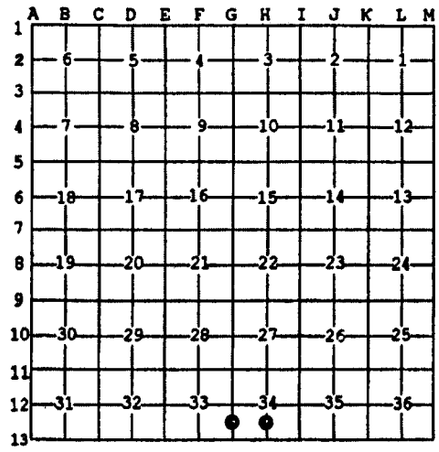

I, Stephan J. Szyszkoski, in a field survey on Oct 24 2006, 20____ do hereby state that under requirements of P.A. 74, Michigan P.A. of 1970, the corner points mentioned in lines 1 and 2 above were in conformance with regulations and rules therefore as required in the current manual of survey instructions of the United States Department of the Interior, Bureau of Land Management or by a decree of a Court of Law and /or that the corner points mentioned in lines 3, 4 and 5 above were in conformance with the rules of the Michigan Board of Land Surveyors or by a Decree of a Court of Law; established, re-established, monumented, recovered, found as expressed below:

NOTE: Not more than 2 corners, all in the same town and range, may be recorded on this certificate.

A. Description of original monument and accessories and/or subsequent restoration:

(14-Sec. 33) South 1/16 corner between Sections 33 and 34. Established in 1984 by K.L.Sackett. Rewitnessed and recorded in 2005 by the undersigned.
(12-Sec. 34) South 1/16 corner, Section 34. Not established in the original survey.

B. Description of corner evidence found and/or method applied in restoring or reestablishing corner:

(14-Sec. 33) Determined the 1984 position to be erroneous by virtue of the remonumentation of Quarter corner G12 by the Gary L. Pisoni PS in 2005. Removed the 1984 monument and reestablished this 1/16 corner midway and on line between Section corner 1321.24 south and Quarter corner 1321.24' north. The 1984 position was found to be 7.9' west of the reestablished position.
(12-Sec. 34) Established the corner midway and on a straight line between Quarter corner 1311.27' south and Center of Section 1311.27' north.

C. Description of monument for corner and accessories established to perpetuate locating the position of the corner:

(14) Set 1"IDx32" I.pipe with 4" alum. MDNR cap. Set measuring nails in:
9" Balsam N21W 24.7' old blazes
7" Balsam N49W 26.8' mrkd "1/16S BT"
4" Cherry N77W 37.9' do
7" Poplar S37E 18.1' do
Sq'd cedar post adjacent. Bearings are magnetic. Distances are to nail with tag.

(12) Set 1"IDx32" I.pipe with 4" alum. MDNR cap. Set measuring nails in:
6" B.Ash N22E 20.2' mrkd "1/16S BT"
14" Cedar S22W 19.5' do
5" B.Ash S75W 17.6' do
12" Cedar N33W 33.7' do
Set sq'd cedar post adjacent. Bearings are magnetic. Distances are to nail with tag.

STATE OF MICHIGAN
STEPHAN J. SZYSZKOSKI
LAND SURVEYOR
No. 33986
LICENSED LAND SURVEYOR

Signed by Stephan J. Szyszkoski Date 10/31/2006

Surveyor's Michigan License No. 33986

For the Michigan Department of Natural Resources, Office of Land and Facilities

FORM APPROVED BY MICHIGAN STATE BOARD OF PROFESSIONAL SURVEYORS, JAN. 28, 1971
Revised May 14, 1975
Revised Jan., 1983
Rervised Oct., 1995