

SURVEY & REMONUMENTATION

APR 27 1995

COMMISSION

LAND CORNER RECORDATION CERTIFICATE Filing Requirement of Act 74, Mich. P.A. 1970

For corners in

Iron
(County)

Located In:

Corner Code #

- | | | | | | |
|------------------------------------|---|-----|---|-----|-----|
| 1. Public Land Survey | T | 44N | R | 33W | B-5 |
| | T | | R | | |
| | T | | R | | |
| | T | | R | | |
| 2. Property Controlling in Section | S | | T | R | |
| | S | | T | R | |
| 3. Miscellaneous Property in Sec. | S | | T | R | |
| | S | | T | R | |

REGISTRAR'S OFFICE) ..SS
IRON COUNTY, MICH.) ..SS
RECEIVED FOR RECORD THE 21ST DAY OF
FEBRUARY A.D. 19 95 AT
2:45 O'CLOCK P. M., AND RECORDED IN LIBER
6 OF L.C. RECORDS
ON PAGE 382
Mark Selnes
DEPUTY REGISTER OF DEEDS

Register of Deeds Stamp & File Number

4. Lot No. _____, Recorded Plat _____
5. Private Claims _____

Quarter Corner 7, 18, T44N, R33W

I, Gary L. Pisoni, in a field survey on November 10, 19 94, do hereby certify that under requirements of P.A. 74, Michigan P.A. of 1970, the corner points mentioned in lines 1 and 2 above were in conformance with regulations and rules therefore as required in the current manual of survey instructions of the United States Department of the Interior, Bureau of Land Management or by a decree of a Court of Law and/or that the corner points mentioned in lines 3, 4 and 5 above were in conformance with the rules of the Michigan Board of Land Surveyors or by a Decree of a Court of Law, established, re-established, monumented, re-monumented, recovered, found as expressed below:

NOTE: Not more than 4 corners, all in the same town and range, may be recorded on this certificate.

A. Description of original monument and accessories and/or subsequent restoration:

Original corner established by Guy H. Carleton, U.S. Deputy Surveyor in 1851.

Original corner: Wood Post

Original bearing trees:

Yellow Birch	16"	N 50° E	8 links (5.28 feet)
Cedar	16"	S 10° W	25 links (16.50 feet)

B. Description of corner evidence found and/or method applied in restoring or reestablishing corner:

No evidence of original corner or bearing tree remains. Corner position found marked by a 3/4" diameter iron pin and located in the centerline of an East/West county road and in the East lane of a county road running South. Corner position has been used and accepted as the corner locally for many years. Corner position checks within reason to GLO distance from the East and West section corners. Set an aluminum pipe monument over the top of the iron pin as described below. Monument is 6" below road bed surface.

This corner is accepted as the best available evidence of the position of the original corner.

County Record Research on file with County Representative office.

PEER GROUP APPROVED

Iron Gary L. Pisoni

COUNTY REPRESENTATIVE

C. Description of monument for corner and accessories established to perpetuate locating the position of the corner: AP. 11-30-94


At the corner position, I set a 2" diameter by 30" long split base aluminum pipe monument with a 3" cast aluminum cap, stamped to read: Iron County Remonumentation, T44N R33W, 1/4, S-7, S-18, 1994, RLS- 27457 from which I established the following new blazed and scribed bearing trees: (all measurements taken to a nail in side of tree)

Iron Pin	5/8" dia.	North	33.00 feet
Balsam	12"	N 51° E	58.59 feet
Utility Pole	#94-03704	S 37° E	39.27 feet
Rebar	5/8" x 30"	S 39° W	47.70 feet
Steel Sign Post		North	33.52 feet

Signed by *Gary L. Pisoni*

Date 1-9-95

Surveyor's Michigan License No. 27457

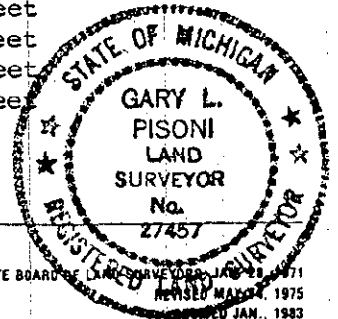

FORM APPROVED BY MICHIGAN STATE BOARD OF LAND SURVEYORS, JAN. 23, 1971
REVISED MAY 17, 1975
REVISED JAN. 1983