

**SURVEY & REMONUMENTATION**

JAN 19 1999

**SECTION**

**LAND CORNER RECORDATION CERTIFICATE**  
**Filing Requirement of Act 74, Mich. P.A. 1970**

For corners in

<u>Iron</u> (County)	Located In:	Corner Code #
1. Public Land Survey	T <u>44N</u> R <u>33W</u>	<u>C-3</u>
	T _____ R _____	_____
	T _____ R _____	_____
	T _____ R _____	_____
2. Property Controlling in Section	S _____ T _____ R _____	_____
	S _____ T _____ R _____	_____
3. Miscellaneous Property in Sec.	S _____ T _____ R _____	_____
	S _____ T _____ R _____	_____

IRON COUNTY  
MICHIGAN  
RECEIVED FOR RECORD

98 DEC 28 AM 11:17  
L.C. Records: L. 7, P. 272  
*Gary L. Pisoni*  
REGISTERED LAND SURVEYOR

Register of Deeds Stamp & File Number

4. Lot No. \_\_\_\_\_, Recorded Plat \_\_\_\_\_  
 5. Private Claims \_\_\_\_\_

Section Corner Sections 5, 6, 7, 8, T44N, R33W

I, Gary L. Pisoni, in a field survey on Nov. 4, 1998 do hereby state that under requirements of P.A. 74, Michigan P.A. of 1970, the corner points mentioned in lines 1 and 2 above were in conformance with regulations and rules therefore as required in the current manual of survey instructions of the United States Department of the Interior, Bureau of Land Management or by a decree of a Court of Law and /or that the corner points mentioned in lines 3, 4 and 5 above were in conformance with the rules of the Michigan Board of Land Surveyors or by a Decree of a Court of Law; established, re-established, monumented, recovered, found as expressed below:

1	A	B	C	D	E	F	G	H	I	J	K	L	M
2		6		5		4		3		2		1	
3			●										
4		7		8		9		10		11		12	
5													
6		18		17		16		15		14		13	
7													
8		19		20		21		22		23		24	
9													
10		30		29		28		27		26		25	
11													
12		31		32		33		34		35		36	
13													

NOTE: Not more than 2 corners, all in the same town and range, may be recorded on this certificate.

A. Description of original monument and accessories and/or subsequent restoration:

Original corner established in 1851 by Guy H. Carleton, U.S. Deputy Surveyor.  
 Original Corner; Wood Post  
 Original Bearing Trees:  
 Cedar 10" N 35° E 24 lks (15.84 feet)  
 Cedar 12" S 60° W 12 lks (7.92 feet)

B. Description of corner evidence found and/or method applied in restoring or reestablishing corner:

No evidence of original B.T.s found. Found a nail marking corner position, 2" below asphalt surface, located in the centerline of an East/West county road and in the centerline of a road running North and South.

Distances to adjoining corners are consistent with GLO distances.

I accept the nail as the best available evidence for restoring the corner position.

Corner record research on file with County Representative.

PEER GROUP APPROVED  
*Iron A. Pisoni 12-18-98*  
 COUNTY REPRESENTATIVE

C. Description of monument for corner and accessories established to perpetuate locating the position of the corner:


From the above described corner position, I set two reference monuments, being a 5/8" diameter by 30" long rebar, with a 3" aluminum cap stamped as follows: Iron County Remonumentation, T44N, R33W, R.M., S-5, S-6, S-7, S-8, S 46° W, 27.16 feet, 1998, RLS 27457; T44N, R33W, R.M., S-5, S-6, S-7, S-8, N 55° W, 40.30 feet, 1998, RLS 27457 from which I blazed and scribed the following new bearing trees: (All measurements taken to a nail in side of tree)

Black Spruce	7"	N 42° W	51.24 feet
R.M.	5/8" x 30" rebar	N 46° E	27.16 feet
R.M.	5/8" x 30" rebar	S 55° E	40.30 feet
Tamarack	13"	S 37° W	95.24 feet
Steel sign post		N 46° E	28.46 feet

98-66

Signed by Gary L. Pisoni Date 12-21-98  
 Surveyor's Michigan License No. 27457

FORM APPROVED BY MICHIGAN STATE BOARD OF PROFESSIONAL SURVEYORS JAN 28, 1971  

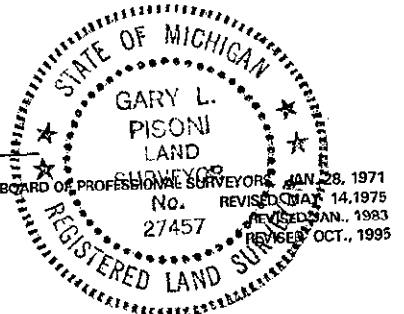

L. 7 P. 272