

MAR 09 2000

SECTION

LAND CORNER RECORDATION CERTIFICATE
Filing Requirement of Act 74, Mich. P.A. 1970

For corners in

_____ Iron _____ (County)	Located In:	Corner Code #
1. Public Land Survey	T <u>44N</u> R <u>R33W</u>	<u>C-5</u>
	T _____ R _____	_____
	T _____ R _____	_____
	T _____ R _____	_____
2. Property Controlling in Section	S _____ T _____ R _____	_____
	S _____ T _____ R _____	_____
3. Miscellaneous Property in Sec.	S _____ T _____ R _____	_____
	S _____ T _____ R _____	_____

IRON COUNTY
MICHIGAN
RECEIVED FOR RECORD


99 DEC 30 AM 10:15
L.C. Records: L. 8, P. 39
Gilbert & Stiel
REGISTERED DEEDS

Register of Deeds Stamp & File Number

4. Lot No. _____, Recorded Plat _____
5. Private Claims _____

Section Corner to Sections 7, 8, 17, 18, T44N, R33W

I, Gary L. Pisoni, in a field survey on Nov. 17, 1999 do hereby state that under requirements of P.A. 74, Michigan P.A. of 1970, the corner points mentioned in lines 1 and 2 above were in conformance with regulations and rules therefore as required in the current manual of survey instructions of the United States Department of the Interior, Bureau of Land Management or by a decree of a Court of Law and /or that the corner points mentioned in lines 3, 4 and 5 above were in conformance with the rules of the Michigan Board of Land Surveyors or by a Decree of a Court of Law; established, re-established, monumented, recovered, found as expressed below:

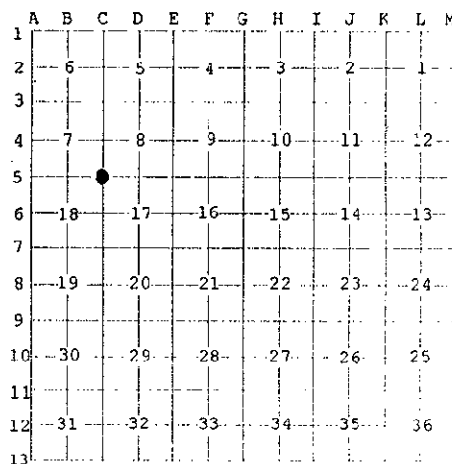

NOTE: Not more than 2 corners, all in the same town and range, may be recorded on this certificate.

A. Description of original monument and accessories and/or subsequent restoration:

Original corner established in June 1851, by Guy H. Carleton, U.S. Deputy Surveyor
Original Corner; Wood Post
Original Bearing Trees:
Sugar 10" N 50° W 32 lks (21.12 feet)
Sugar 14" S 64° E 30 lks (19.80 feet)

PEER GROUP APPROVED
Iron County 12-21-99
COUNTY REPRESENTATIVE

On 4/14/77, Arthur O. Enger, RLS, DNR, set an 8" galvanized gutter spike, 6" below roadbed surface, located at the intersections of the centerlines of an East/West and a North/South county road, recorded in Liber 2b, Page 12 of LC records.

1977 Reference objects:
Power Pole S 26° W 58.38 feet
Stop sign steel post N 59° E 40.25 feet

B. Description of corner evidence found and/or method applied in restoring or reestablishing corner:

On 11/17/99, found the above described gutter spike. I accept the gutter spike as the best available evidence for restoring the corner position. This corner position has been used for many surveys in the surrounding areas.


Corner record research on file with County Representative.

C. Description of monument for corner and accessories established to perpetuate locating the position of the corner:

Set two (2) reference monuments being a 5/8" diameter by 30" long rebar pin with a 3" diameter aluminum cap stamped as follows: Iron County Remonumentation, T44N, R33W, R.M., S-7, S-8, S-18, S-17, N 29°W, 55.65 feet, 1999, RLS 27457; T44N, R33W, R.M., S-7, S-8, S-18, S-17, S 58° E, 53.20 feet, 1999, RLS 27457 from which I established the following new reference objects:

Rebar	5/8" x 30" rebar	N 52° E	40.74 feet
R.M.	5/8" x 30" rebar	S 29° E	55.65 feet
Utility Pole	85-22651	S 32° W	52.98 feet
R.M.	5/8" x 30" rebar	N 58° W	53.20 feet
Steel sign post		S 29° E	56.50 feet

99-39
Signed by Gary L. Pisoni Date 12-28-99
Surveyor's Michigan License No. 27457

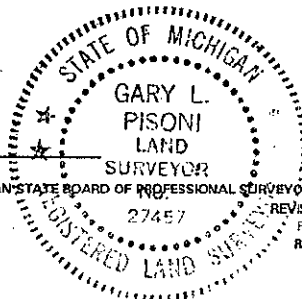

FORM APPROVED BY MICHIGAN STATE BOARD OF PROFESSIONAL SURVEYORS, JAN. 28, 1971
REVISED MAY 14, 1975
REVISED JAN., 1983
REVISED OCT., 1995