

MAR 09 2000

SECTION

LAND CORNER RECORDATION CERTIFICATE
Filing Requirement of Act 74, Mich. P.A. 1970

For corners in

<u>Iron</u> (County)	Located In:	Corner Code #
1. Public Land Survey	T <u>44N</u> R <u>R33W</u>	<u>E-7</u>
	T ___ R ___	_____
	T ___ R ___	_____
	T ___ R ___	_____
2. Property Controlling in Section	S ___ T ___ R ___	_____
	S ___ T ___ R ___	_____
3. Miscellaneous Property in Sec.	S ___ T ___ R ___	_____
	S ___ T ___ R ___	_____

IRON COUNTY
MICHIGAN
RECEIVED FOR RECORD

99 DEC 30 AMID: 30
L.C. Records: L.S. P. 117
Gary L. Pisoni
REGISTER OF DEEDS


Register of Deeds Stamp & File Number

4. Lot No. _____, Recorded Plat _____
5. Private Claims _____

Section corner 16, 17, 20 & 21, T44N R33W

I, Gary L. Pisoni, in a field survey on June 19, 1995 do hereby state that under requirements of P.A. 74, Michigan P.A. of 1970, the corner points mentioned in lines 1 and 2 above were in conformance with regulations and rules therefore as required in the current manual of survey instructions of the United States Department of the Interior, Bureau of Land Management or by a decree of a Court of Law and /or that the corner points mentioned in lines 3, 4 and 5 above were in conformance with the rules of the Michigan Board of Land Surveyors or by a Decree of a Court of Law; established, re-established, monumented, recovered, found as expressed below:

NOTE: Not more than 2 corners, all in the same town and range, may be recorded on this certificate.

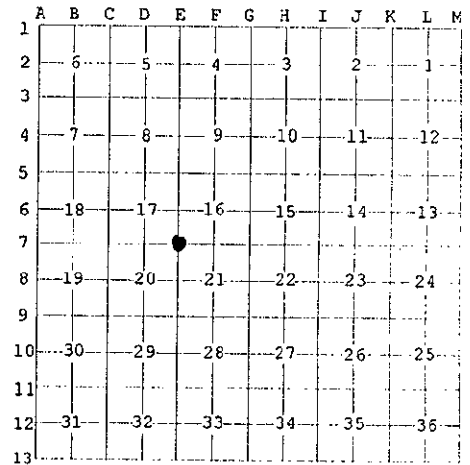

A. Description of original monument and accessories and/or subsequent restoration:

Original corner established by Guy H. Carleton, U.S. Deputy Surveyor on June 11, 1851.

Original corner: Wood Post

Original bearing trees:

Yellow Birch	16"	N 10° W	37 links (24.42 feet)
Yellow Birch	12"	S 35° E	21 links (13.86 feet)

PEER GROUP APPROVED
Gary L. Pisoni 12-21-99
COUNTY REPRESENTATIVE

B. Description of corner evidence found and/or method applied in restoring or reestablishing corner:

No original corner evidence found.

Corner located in middle of farm field.


Set the Section corner by double proportionate measurement methods from the 1/4 between Sections 16 & 21 and the Southwest corner of Section 17 and between the Northeast corner of Section 17 and the Southeast corner of Section 20.

Corner Record Research on file with County Representative.

C. Description of monument for corner and accessories established to perpetuate locating the position of the corner:

At the corner position, I set a 2" diameter by 30" long split base aluminum pipe monument with a 3" cast aluminum cap, stamped to read: Iron County Remonumentation, T44N, R33W, S-17, S-16, S-20, S-21, 1995, RLS-27457 from which I established the following new blazed and scribed bearing trees: (all measurements taken to a nail in side of tree)

Rebar	5/8" x 30"	N 28° E	16.79 feet
Rebar	5/8" x 30"	S 40° E	16.11 feet
Rebar	5/8" x 30"	N 45° W	15.95 feet
Steel Sign Post	6'	S 68° W	1.35 feet

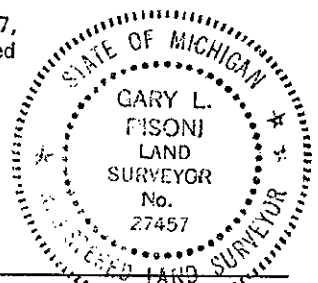

99-117
Signed by Gary L. Pisoni
Surveyor's Michigan License No. 27457

Date 12-28-99