

MAR 09 2000

SECTION

LAND CORNER RECORDATION CERTIFICATE
Filing Requirement of Act 74, Mich. P.A. 1970

For corners in

Form with fields for Iron (County), Located In: T 44N R 33W, Corner Code # G-9, and sections 1-3 for Public Land Survey, Property Controlling, and Miscellaneous.

IRON COUNTY MICHIGAN RECEIVED FOR RECORD

99 DEC 30 AM 10:15
L.C. Records L. 8, P. 35
[Signature]


Register of Deeds Stamp & File Number

4. Lot No. , Recorded Plat
5. Private Claims

Section Corner to Sections 21, 22, 27, 28, T44N, R33W

I, Gary L. Pisoni, in a field survey on Nov. 17, 1999 do hereby state that under requirements of P.A. 74, Michigan P.A. of 1970, the corner points mentioned in lines 1 and 2 above were in conformance with regulations and rules therefore as required in the current manual of survey instructions of the United States Department of the Interior, Bureau of Land Management or by a decree of a Court of Law and /or that the corner points mentioned in lines 3, 4 and 5 above were in conformance with the rules of the Michigan Board of Land Surveyors or by a Decree of a Court of Law; established, re-established, monumented, recovered, found as expressed below:

NOTE: Not more than 2 corners, all in the same town and range, may be recorded on this certificate.

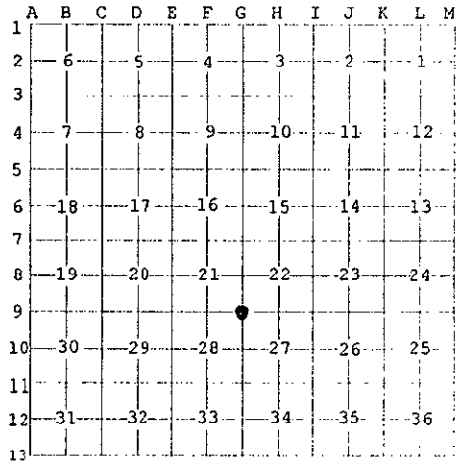

A. Description of original monument and accessories and/or subsequent restoration:

Original corner established in June, 1851 by Guy H. Carleton, U.S. Deputy Surveyor. Original Corner; Wood Post Original Bearing Trees: Sugar 10" N 54° W 34 lks (22.44 feet) Sugar 10" S 62° E 34 lks (22.44 feet)

PEER GROUP APPROVED
IRON Gary L. Pisoni 12-21-99
COUNTY REPRESENTATIVE

B. Description of corner evidence found and/or method applied in restoring or reestablishing corner:

No evidence of original corner B.T.s found.

Restored the corner position in the centerline of a North/South county road and on an old fenceline running to the East. Distances East, West, North and South are consistent with GLO distances. I accept this location as the best available evidence for restoring the corner position.

Corner record research on file with County Representative.

C. Description of monument for corner and accessories established to perpetuate locating the position of the corner:

At the corner position, set a 2" diameter by 30" long split base aluminum pipe monument, 6" below roadbed surface with a 3" aluminum cap stamped as follows: Iron County Remonumentation, T44N, R33W, S-21, S-22, S-27, S-28, 1999, RLS 27457 from which I established the following new blazed and scribed bearing trees:(All measurements taken to a nail in side of tree)

Table with 4 columns: Monument Type, Diameter, Bearing, and Distance. Includes Sugar Maple, White Spruce, Utility Pole, Iron Bar, and Steel sign post.

99-35 Signed by Gary L. Pisoni Date 12-28-99

Surveyor's Michigan License No. 27457

FORM APPROVED BY MICHIGAN STATE BOARD OF PROFESSIONAL SURVEYORS. JAN. 28, 1971 REVISED MAY 14, 1975 REVISED JAN., 1983 REVISED OCT., 1995

