

**SURVEY &
REMONUMENTATION**

JAN 19 1999

SECTION

**LAND CORNER RECORDATION CERTIFICATE
Filing Requirement of Act 74, Mich. P.A. 1970**

For corners in

<u>Iron</u> (County)	Located In:	Corner Code #
1. Public Land Survey	T <u>44N</u> R <u>33W</u>	<u>G-10</u>
	T _____ R _____	_____
	T _____ R _____	_____
	T _____ R _____	_____
2. Property Controlling in Section	S _____ T _____ R _____	_____
	S _____ T _____ R _____	_____
3. Miscellaneous Property in Sec.	S _____ T _____ R _____	_____
	S _____ T _____ R _____	_____

IRON COUNTY
MICHIGAN
RECEIVED FOR RECORD

98 DEC 28 AM 11:13

L.C. Record 1.7, P. 249

Gilbert J. Pisoni
REGISTERED LAND SURVEYOR

Register of Deeds Stamp & File Number

4. Lot No. _____, Recorded Plat _____
5. Private Claims _____

Quarter Corner Sections 27 and 28, T44N, R33W

I, Gary L. Pisoni, in a field survey on October 24, 1998 do hereby state that under requirements of P.A. 74, Michigan P.A. of 1970, the corner points mentioned in lines 1 and 2 above were in conformance with regulations and rules therefore as required in the current manual of survey instructions of the United States Department of the Interior, Bureau of Land Management or by a decree of a Court of Law and /or that the corner points mentioned in lines 3, 4 and 5 above were in conformance with the rules of the Michigan Board of Land Surveyors or by a Decree of a Court of Law; established, re-established, monumented, recovered, found as expressed below:

A	B	C	D	E	F	G	H	I	J	K	L	M
1												
2	6		5		4		3		2		1	
3												
4	7		8		9		10		11		12	
5												
6	18		17		16		15		14		13	
7												
8	19		20		21		22		23		24	
9												
10	30		29		28	●	27		26		25	
11												
12	31		32		33		34		35		36	
13												

NOTE: Not more than 2 corners, all in the same town and range, may be recorded on this certificate.

A. Description of original monument and accessories and/or subsequent restoration:

Original corner established in June 1851 by Guy H. Carleton, U.S. Deputy Surveyor.

Original Corner; Wood Post
Original Bearing Trees:

Sugar	12"	S 81° W	14 lks (9.24 feet)
Sugar	10"	N 88° E	62 lks (40.92 feet)

B. Description of corner evidence found and/or method applied in restoring or reestablishing corner:

No evidence of original B.T.s found.

Set the quarter corner position in the centerline of a North/South county road and on an old fence line running East and West. I accept this method as the best available evidence for restoring the corner position.

Distances to the North and South are consistent with GLO distances.

Corner record research on file with County Representative.

PEER GROUP APPROVED
Iron County 11-24-98
COUNTY REPRESENTATIVE

C. Description of monument for corner and accessories established to perpetuate locating the position of the corner:

At the corner position, set a 2" diameter by 30" long split base aluminum pipe monument, 6" below road bed surface with a 3" aluminum cap stamped as follows: Iron County Remonumentation, T44N, R33W, 1/4, S-27, S-28, 1998, RLS 27457 from which I established the following new blazed and scribed bearing trees: (All measurements taken to a nail in side of tree)

Rebar	5/8"x30"	N 39° E	52.95 feet
White Pine	8"	S 50° E	80.50 feet
Power Pole	#95-08113	S 15° W	125.13 feet
Rebar	5/8"x30"	N 87° W	33.34 feet
Steel sign post		N 87° W	34.14 feet

98-78

Signed by

Gary L. Pisoni


Date

12-21-98

Surveyor's Michigan License No.

27457

FORM APPROVED BY MICHIGAN STATE BOARD OF PROFESSIONAL SURVEYORS, JAN 28, 1971
NO. 27457
REVISED MAY 21, 1975
REVISED JAN., 1983
REVISED OCT., 1995

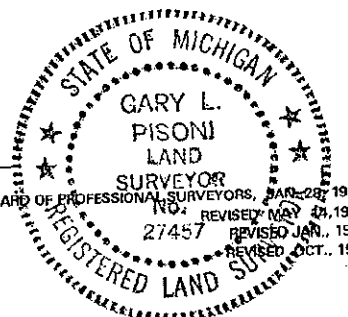

1.7 P. 249